


T. 16S. R. 43E.W.M.

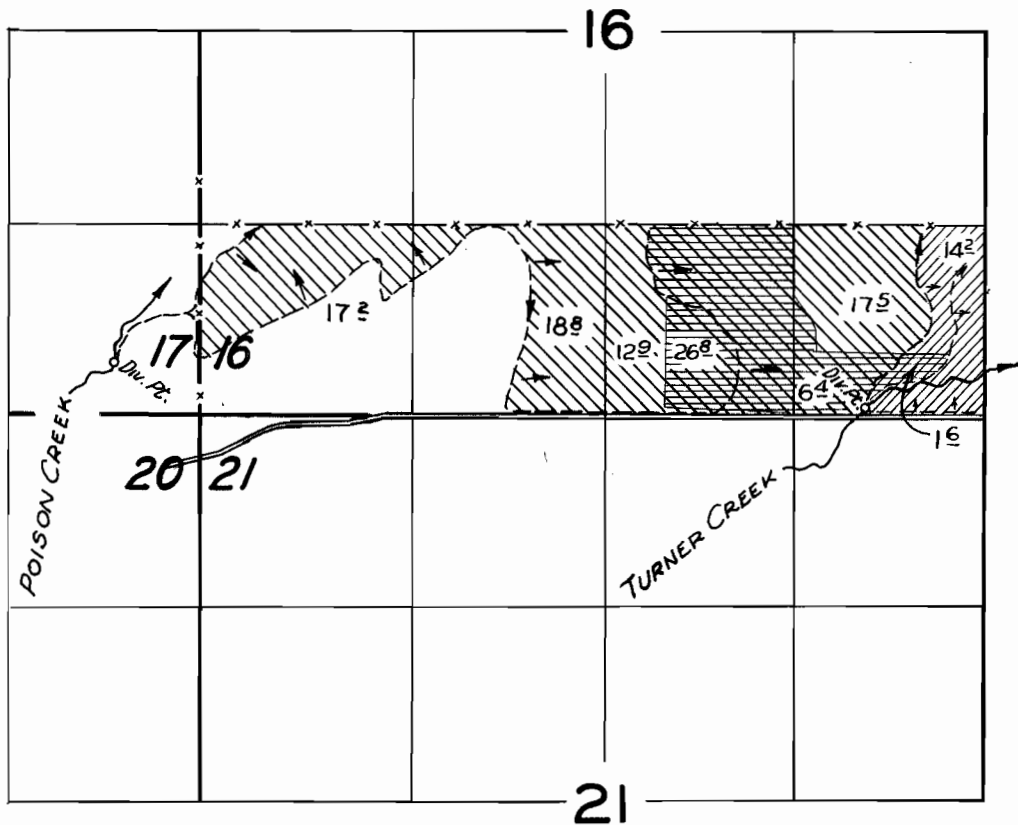

FINAL PROOF SURVEY

UNDER

Poison Creek
Turner Creek
Supplemental



Application No. 28356... Permit No. 22376
IN NAME OF

RALPH E. ALTIG

Surveyed 25 Oct. 1958, by C. O. Bartels.