


T.24 & 25 S. R.34 E. W.M.

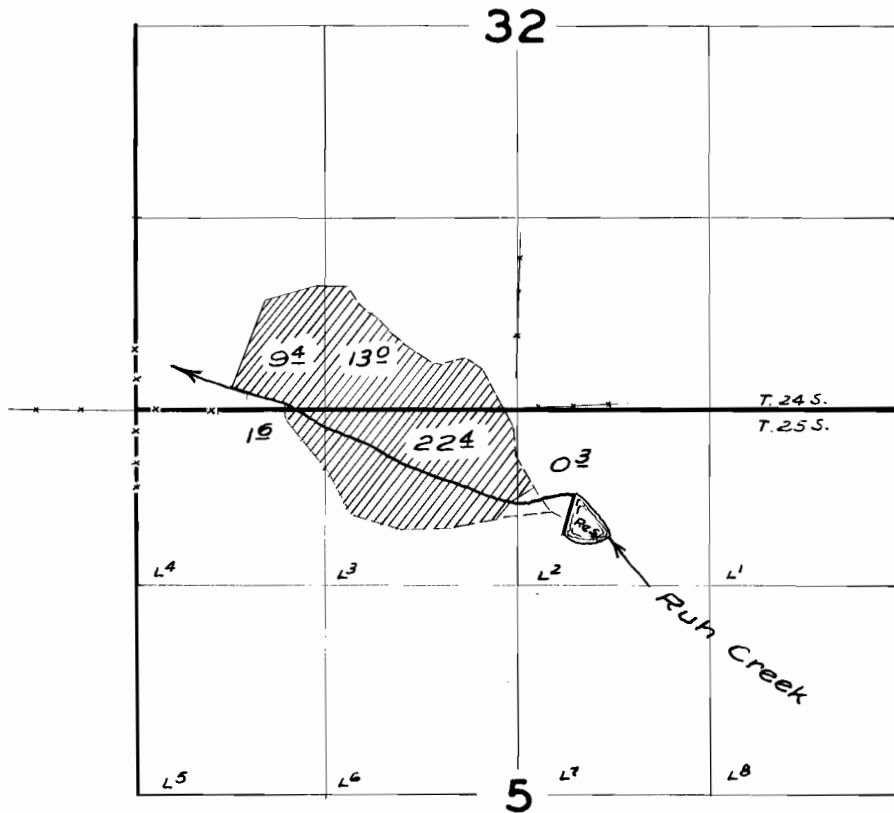

FINAL PROOF SURVEY UNDER

Application No. 28398 Permit No. 22460
IN NAME OF

CHARLES RUH

Surveyed 12 Aug. 1958, by M. Bish