


T.2 S.R.1 E.W. M.

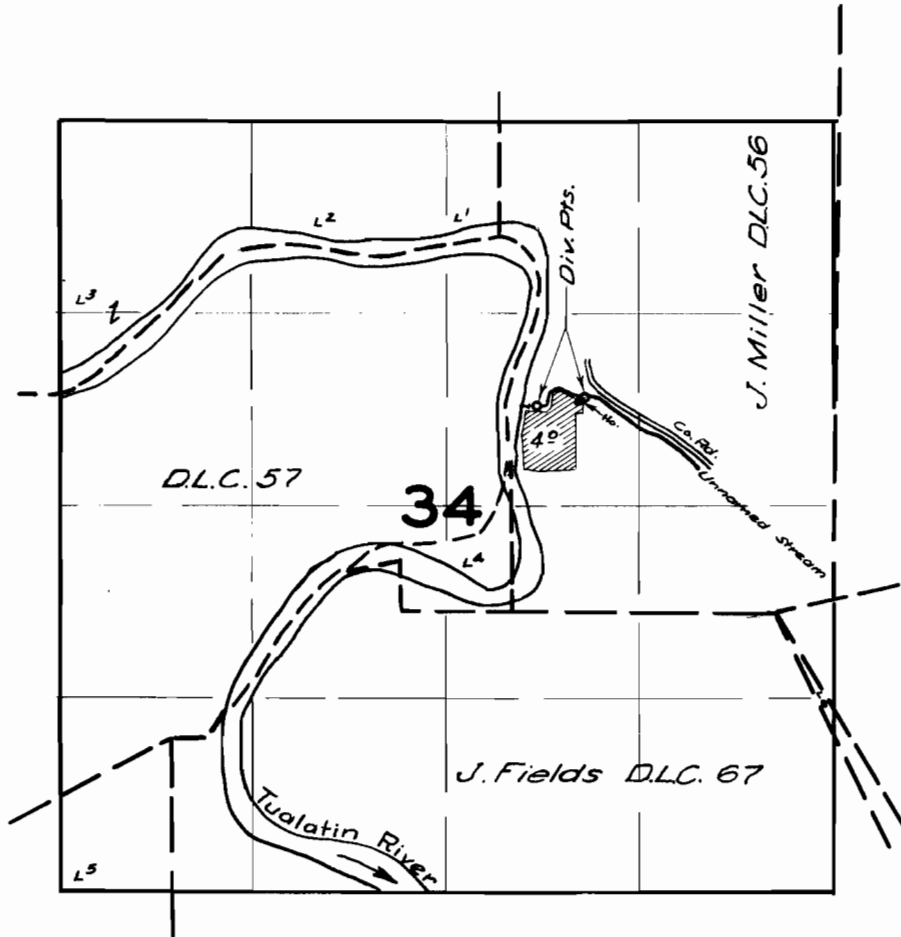

FINAL PROOF SURVEY UNDER

Application No. 28429 Permit No. 22465
IN NAME OF

Frank C. Mosher

Surveyed 7 Nov 1958, by *m. Bish*