


T.9S. R.5W.W.M.

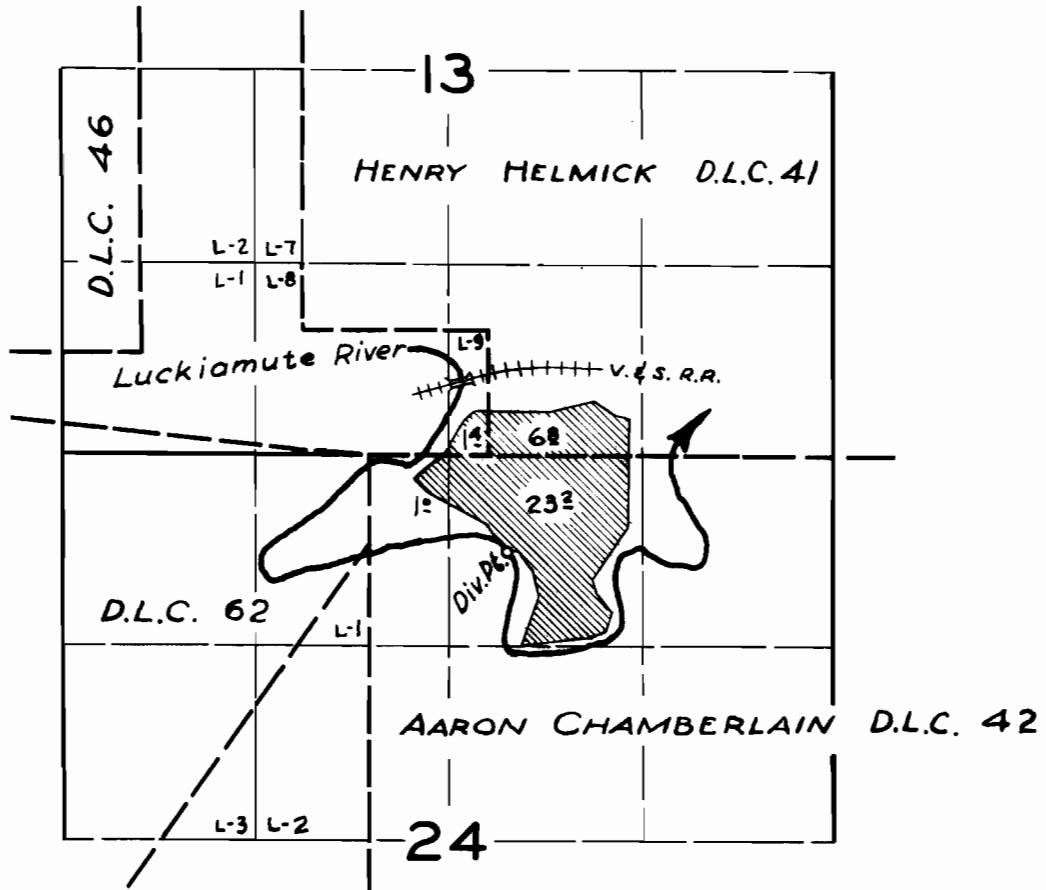

FINAL PROOF SURVEY
UNDER

Application No. 28638. Permit No. 22548.
IN NAME OF

J. S. DICKINSON

Surveyed May 20, 1958., by *R.H. Whitby*