


T.8 S.R.1 E.W.W.M.

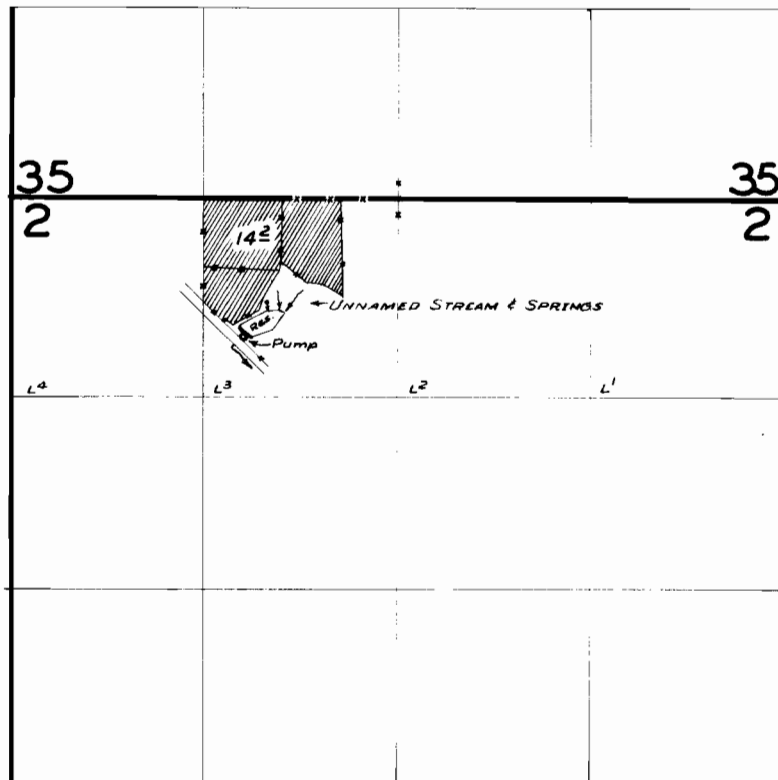

FINAL PROOF SURVEY UNDER

Application No. 28077 Permit No. 22559
IN NAME OF

Orville Page

Surveyed 1 Aug. 1958, by M. Bish

1958-D