


T.12S. R.1W.W.M.

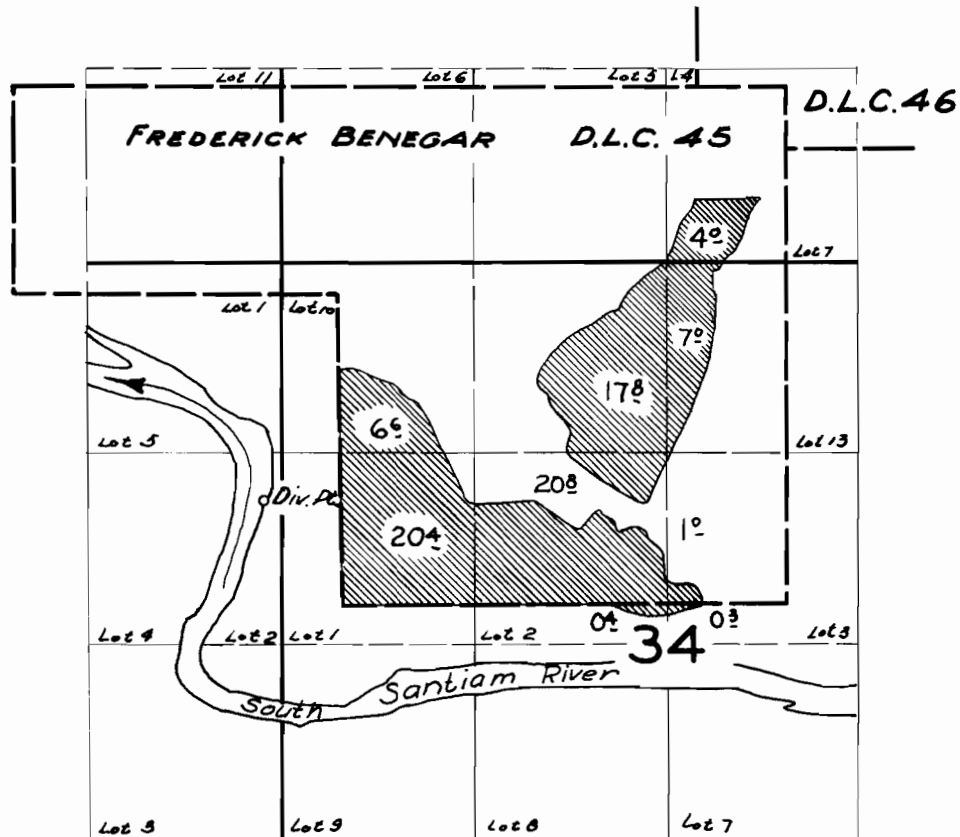

FINAL PROOF SURVEY
UNDER

Application No. 28750 Permit No. 22617
IN NAME OF

H.R. & ELEANOR GROVES

Surveyed 18 July 1958, by C.O. Bartels..