


T. 3S. R. 4E. W.M.

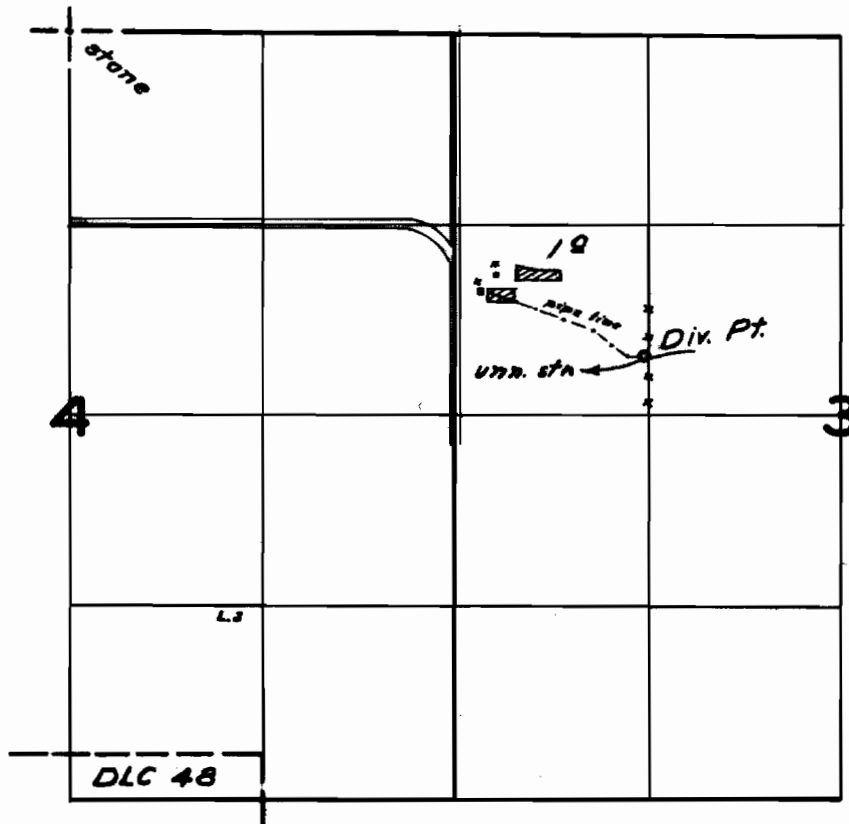

FINAL PROOF SURVEY
UNDER

Application No. 28828 Permit No. 22685
IN NAME OF

George Newell

Surveyed Oct. 2 1958, by W.N. Perry