


T.I.S. R.I.E.W.M.

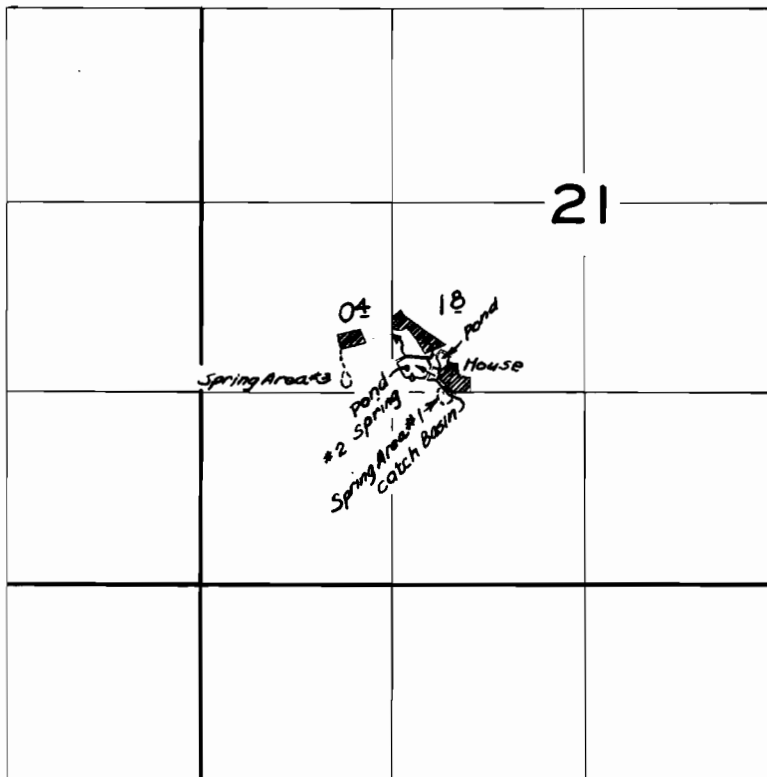

FINAL PROOF SURVEY
UNDER

Application No. 28881... Permit No. 22710
IN NAME OF

ROBERT H. & CHRISTINA GENTNER

Surveyed 9 July 1958, by C.O. Bartels.