


T.13 S. R.1 W.W.M.

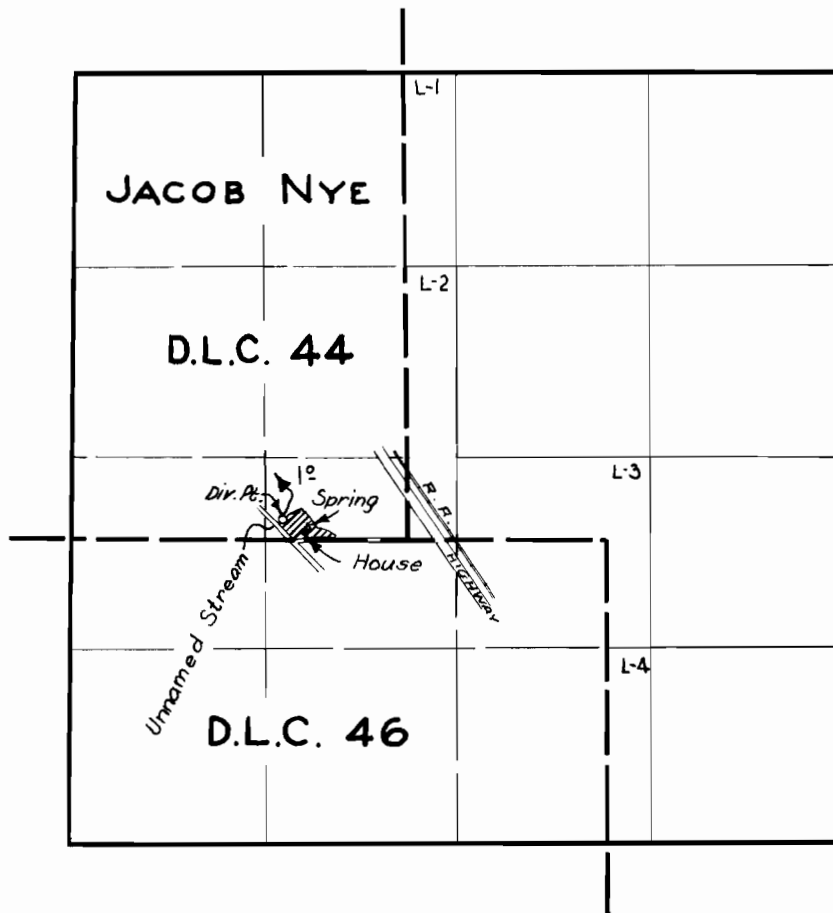

FINAL PROOF SURVEY
UNDER

Application No. 29066... Permit No. 22861...
IN NAME OF

OTTO F. & MABEL L. WALBERG

Surveyed 4 SEPT. 1959, by C.O. BARTELS.