


T.6S. R.38E.W.M.

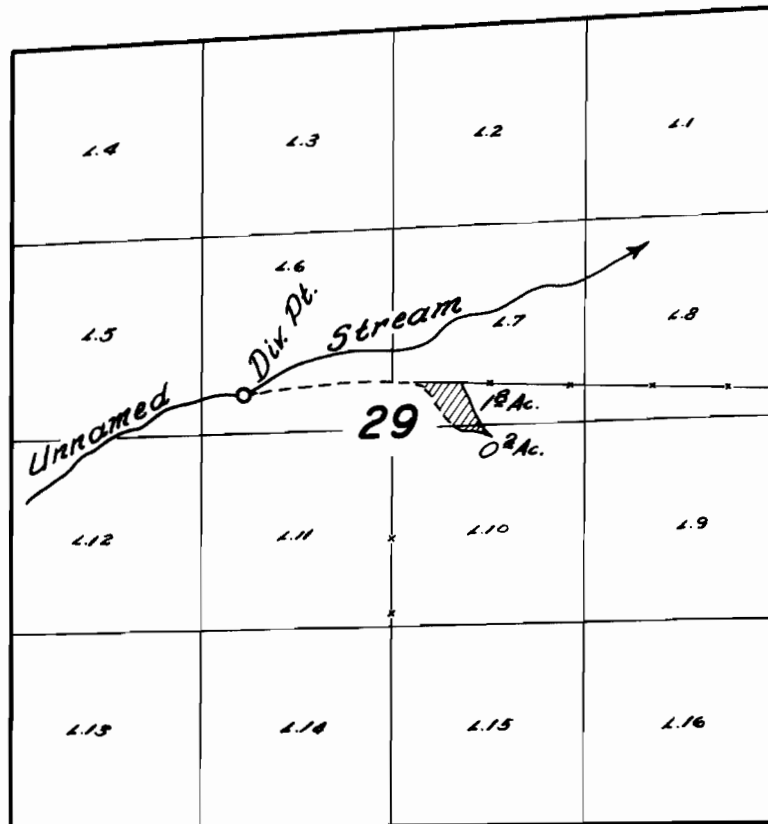

FINAL PROOF SURVEY
UNDER

Application No. 28959... Permit No. 22906...
IN NAME OF

..... J. O. Jacobson

Surveyed Sept. 19 1958, by C. O. Bartlett