


T.9S. R.5 W.W.M.

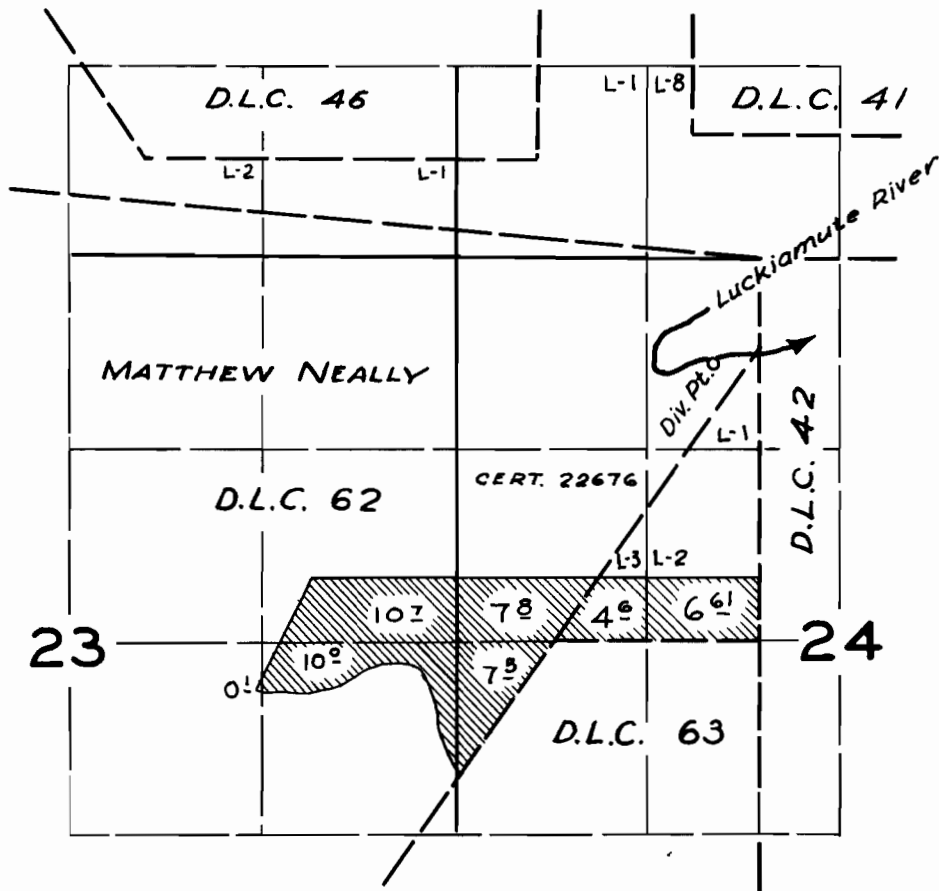

FINAL PROOF SURVEY
UNDER

Application No. 29187... Permit No. 22946.
IN NAME OF

E. H. LORENCE

Surveyed Aug. 15, 1956, by R.H. Whitby