


T.12S. R. 4 W.W.M.

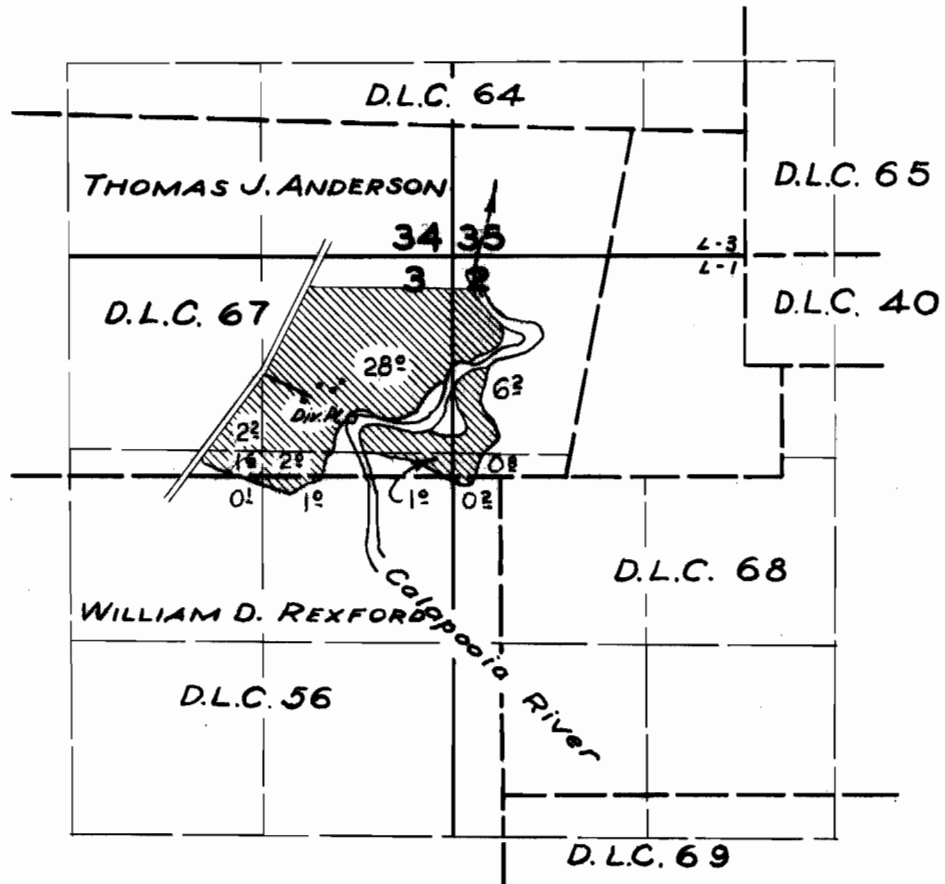

FINAL PROOF SURVEY
UNDER

Application No. 29274 Permit No. 23019
IN NAME OF

GLENN & BEATRICE PIGSLEY

Surveyed 15 July 1958, by C.O. Bartels.