


T.8S.R.38E.W.M.

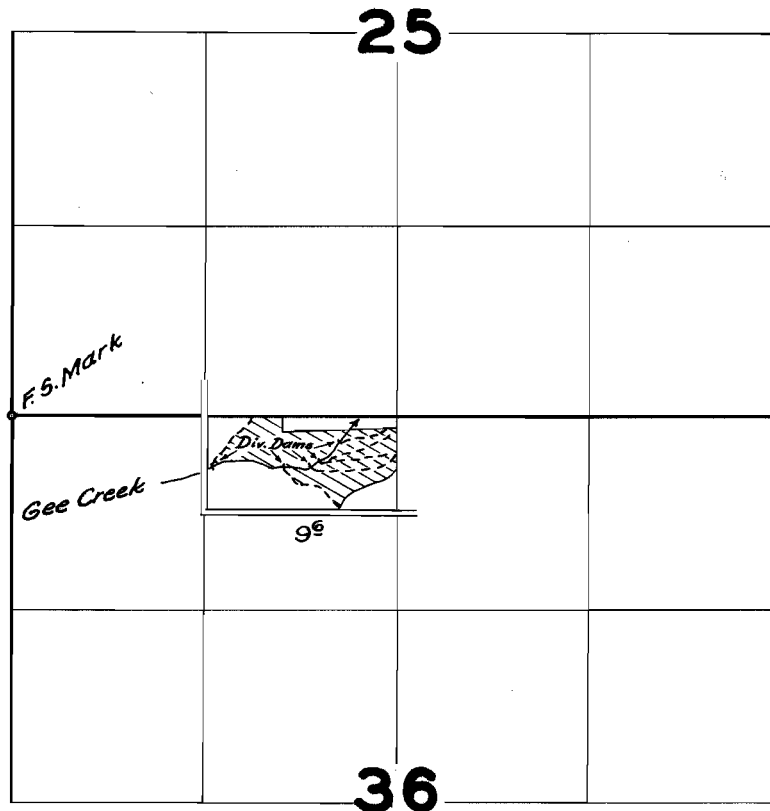

FINAL PROOF SURVEY
UNDER

Application No. 29190 Permit No. 23235
IN NAME OF

D. R. Whittemore

Surveyed Sept. 23 1958, by C. O. Burtis