


T.18S. R.47E.W.M.

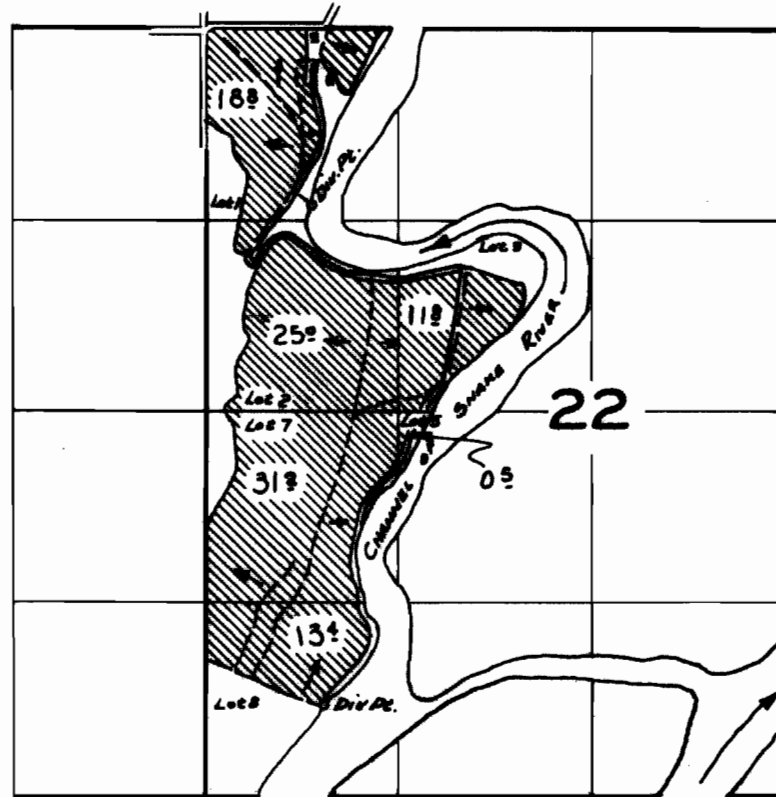

**FINAL PROOF SURVEY**  
UNDER

Application No. 29561... Permit No. 23286.  
IN NAME OF

**WAYNE E. & ISABELLE ELDER**

Surveyed 29 Oct. 1958, by C. O. Bartels.