


T. 4 S. R. 2 W.W.M.

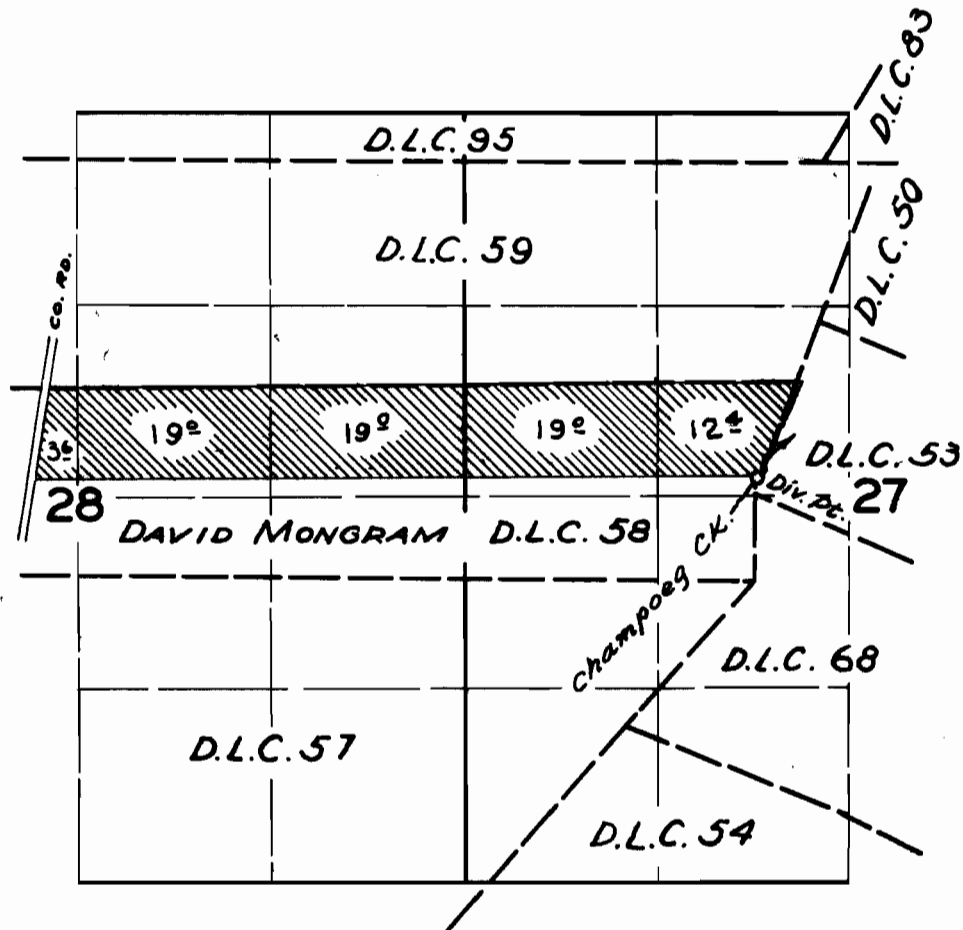

FINAL PROOF SURVEY
UNDER

Application No. 29678.. Permit No. 23316..
IN NAME OF

ARTHUR M. MCKAY

Surveyed 11 June 1958, by C.O. Bartels