


T. 2S. R.1E. W.M.

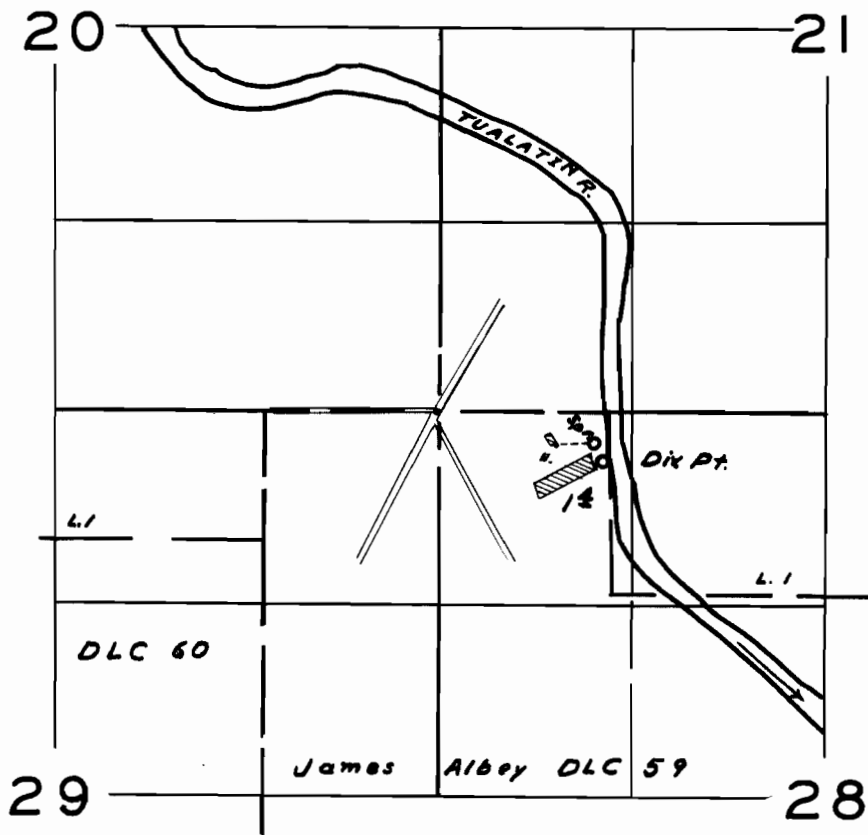

FINAL PROOF SURVEY
UNDER

Application No. 29692 Permit No. 23379
IN NAME OF

Otto C. Rieglmann

Surveyed July 31, 1958, by W.N. Perry