


T.18S.R.47 E.W.M.

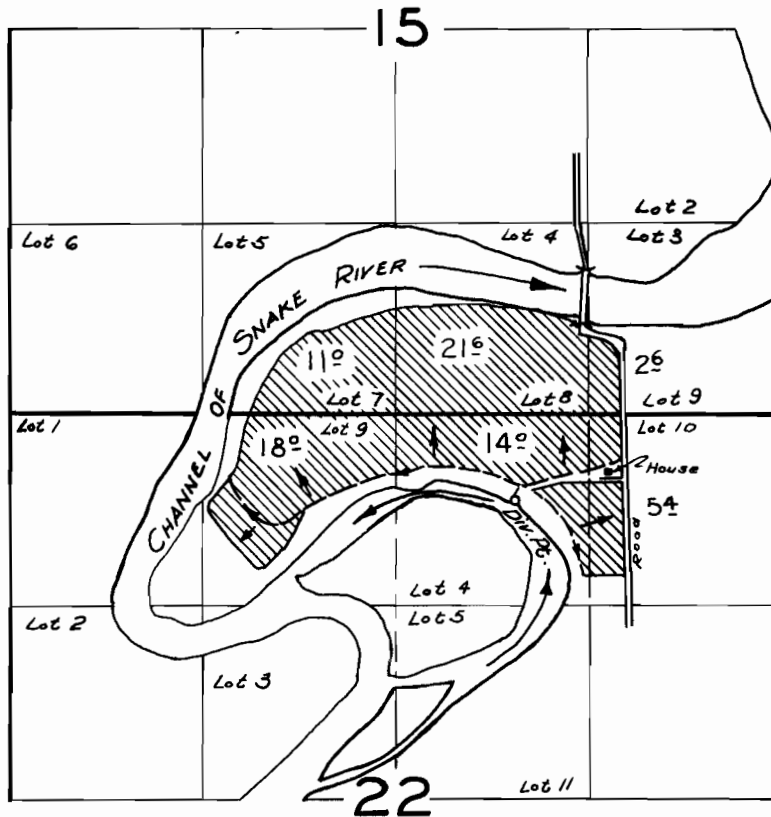

FINAL PROOF SURVEY
UNDER

Application No. 29731. Permit No. 23408
IN NAME OF

CHESTER TSUDA

Surveyed 29 Oct. 1958, by C.O. Bartels