


T. 36 S., R. 4 W., W.M.

Scale: 1" = 400'

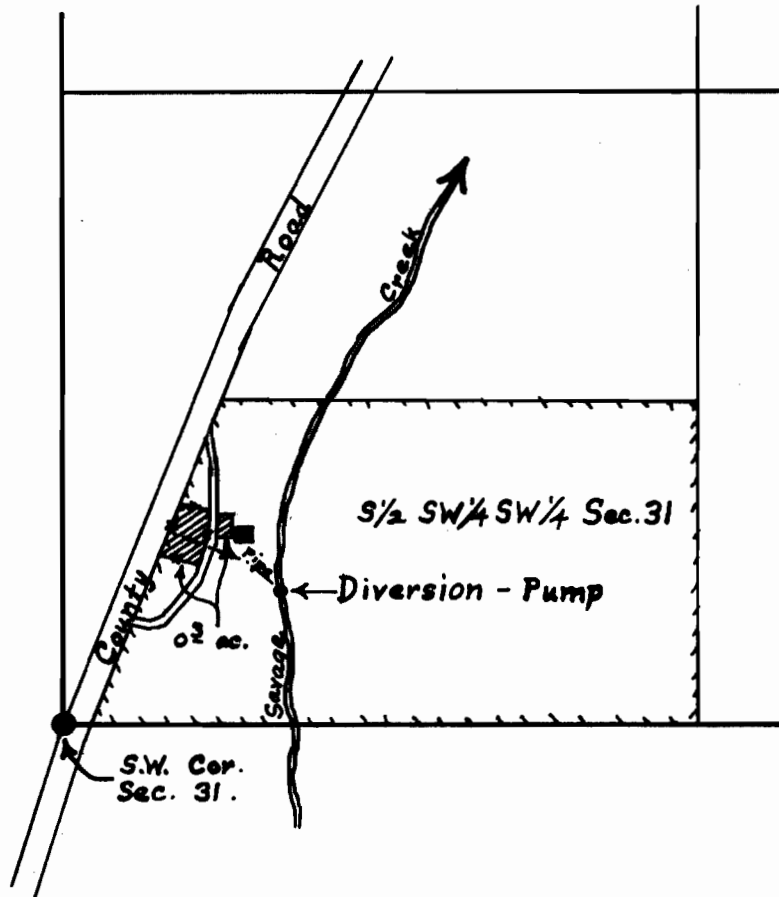

FINAL PROOF SURVEY UNDER

Application No. 29765 Permit No. 23441
IN NAME OF

Albert C. Bullard

Surveyed Dec. 22, 1959, by D.C. Hendrix, W.M.