


T.24 S.R.11 W.W.M.

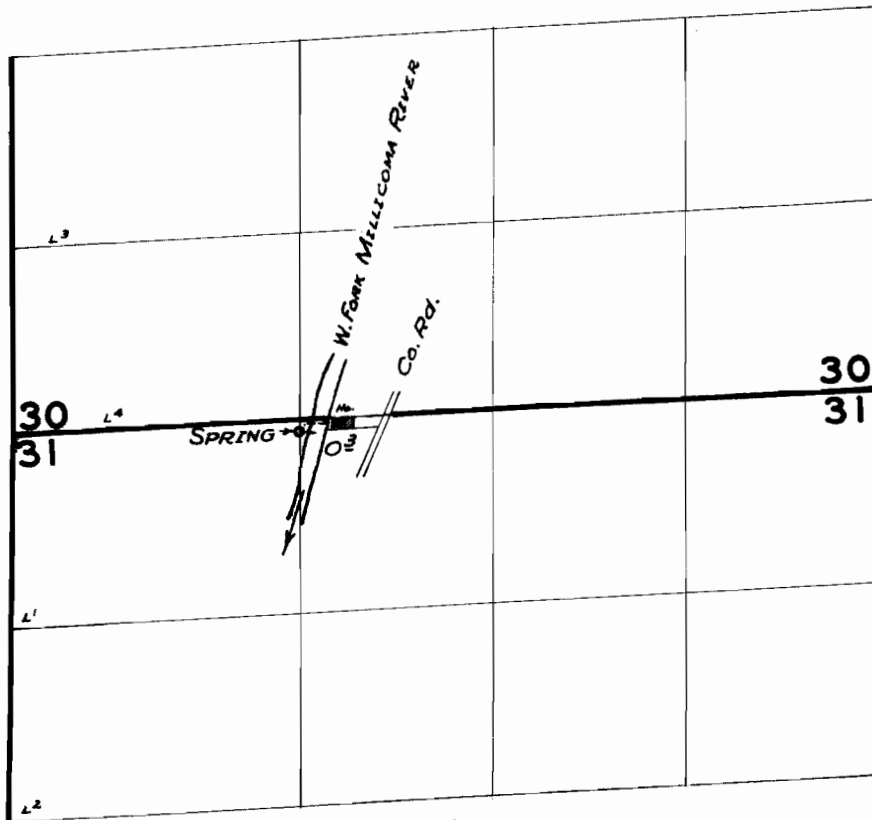

FINAL PROOF SURVEY
UNDER

Application No. 29902. Permit No. 23545.
IN NAME OF

James W. Gaines

Surveyed *17 July 1958*, by *Tom Bish*