


T. 1 S. R. 3 W. W. M.

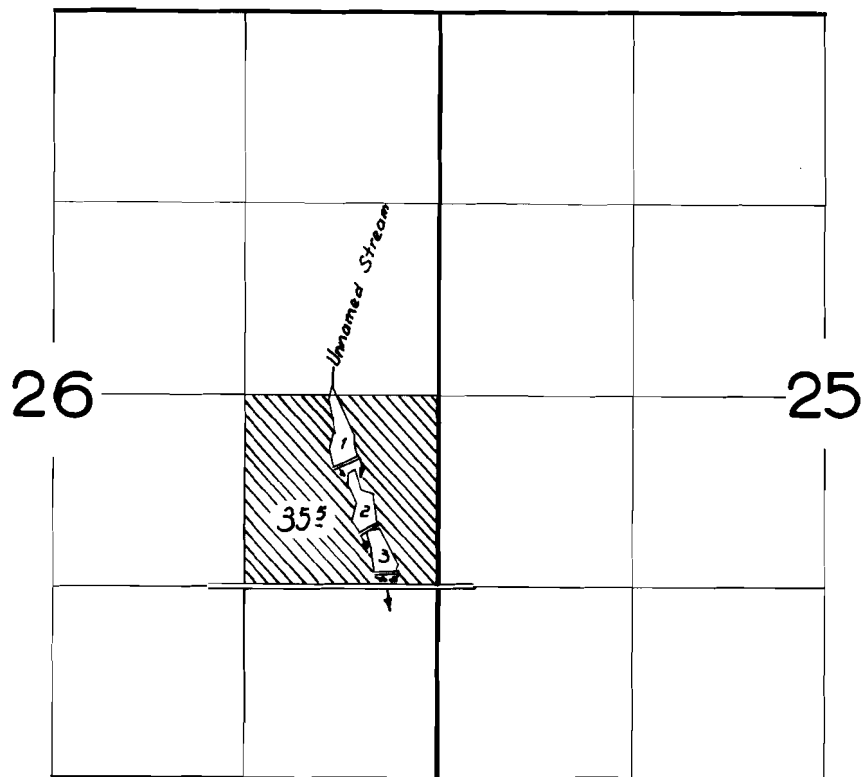

**FINAL PROOF SURVEY**  
UNDER

Application No. <sup>R-30301</sup> 30302 Permit No. <sup>R-1772</sup> 23730...  
IN NAME OF

*FREDERICK M. MENZEL*

Surveyed 26 May 1959, by *R. Jackson*