


T. 1 S. R. 3 W. W. M.

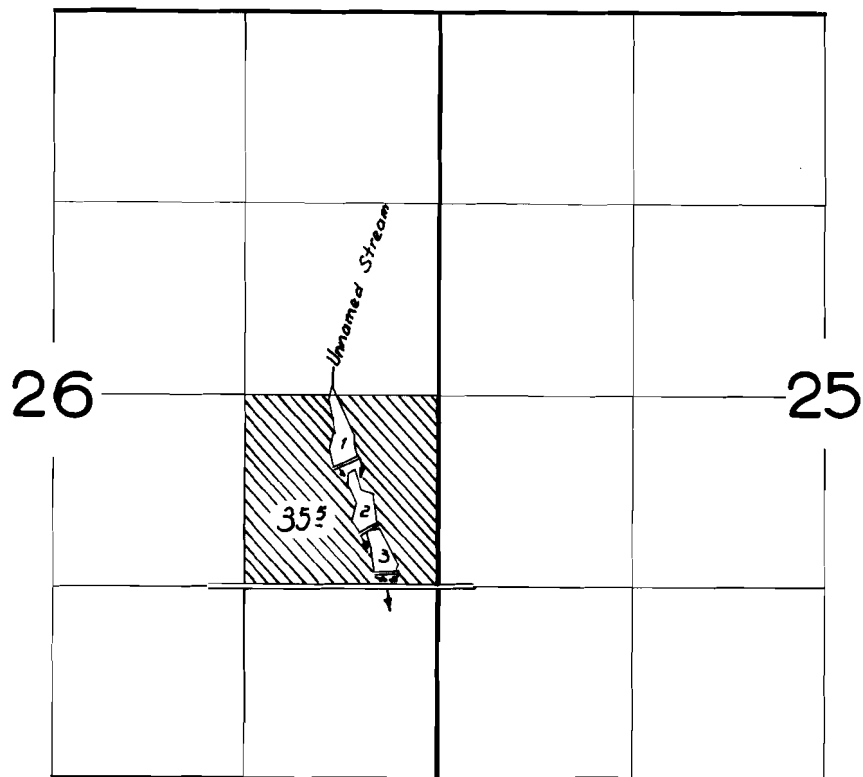

FINAL PROOF SURVEY
UNDER

Application No. ^{R-30301} 30302 Permit No. ^{R-1772} 23730...
IN NAME OF

FREDERICK M. MENZEL

Surveyed 26 May 1959, by *R. Jackson*