


T. 14S. R. 3W. W.M.

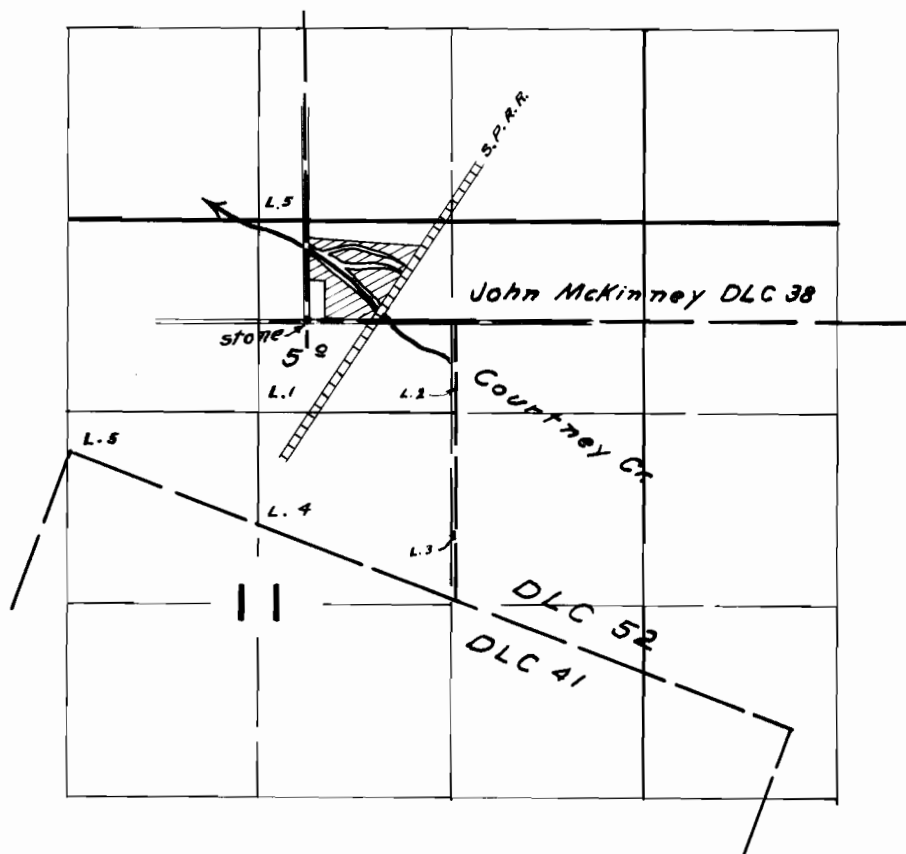

**FINAL PROOF SURVEY**  
UNDER

Application No. 30420 Permit No. 23896  
IN NAME OF

Willard & Doris J. Keen

Surveyed Sept. 10, 1958, by W. N. Perry