


T.25S.R.12W.W.M.

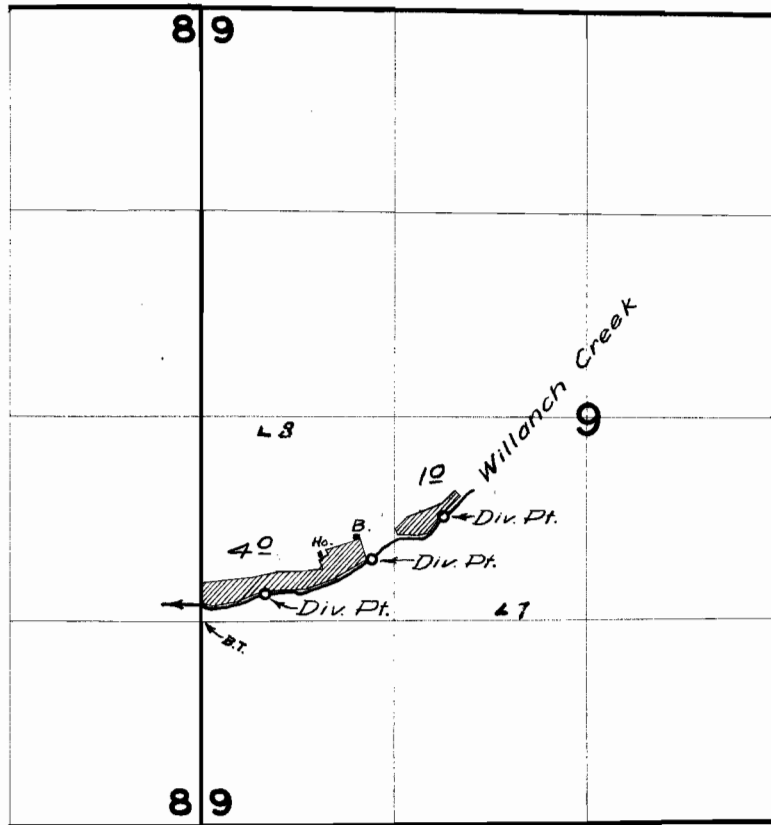

FINAL PROOF SURVEY UNDER

Application No. 29327 Permit No. 23928
IN NAME OF

C. J. Robinson

Surveyed 15 July 1958, by M. A. Bish