


T.8S. R.7 W.W.M.

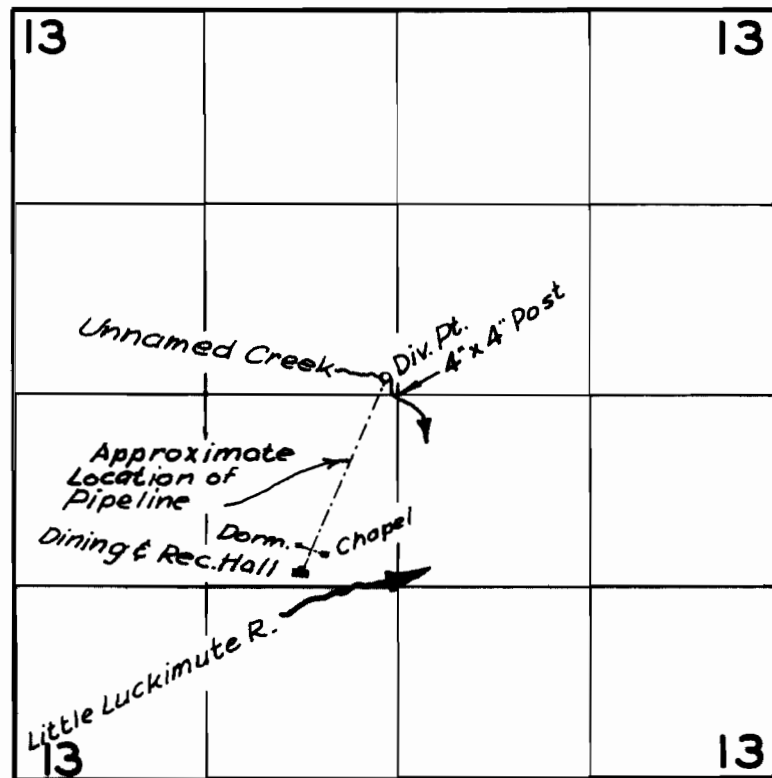

FINAL PROOF SURVEY
UNDER

Application No. 29339... Permit No. 23931...
IN NAME OF

OREGON BAPTIST CONFERENCE GROUNDS, INC.

Surveyed May 13, 1958, by R.H. Whitby...