


# T. 1S. R. 3 W.W.M.

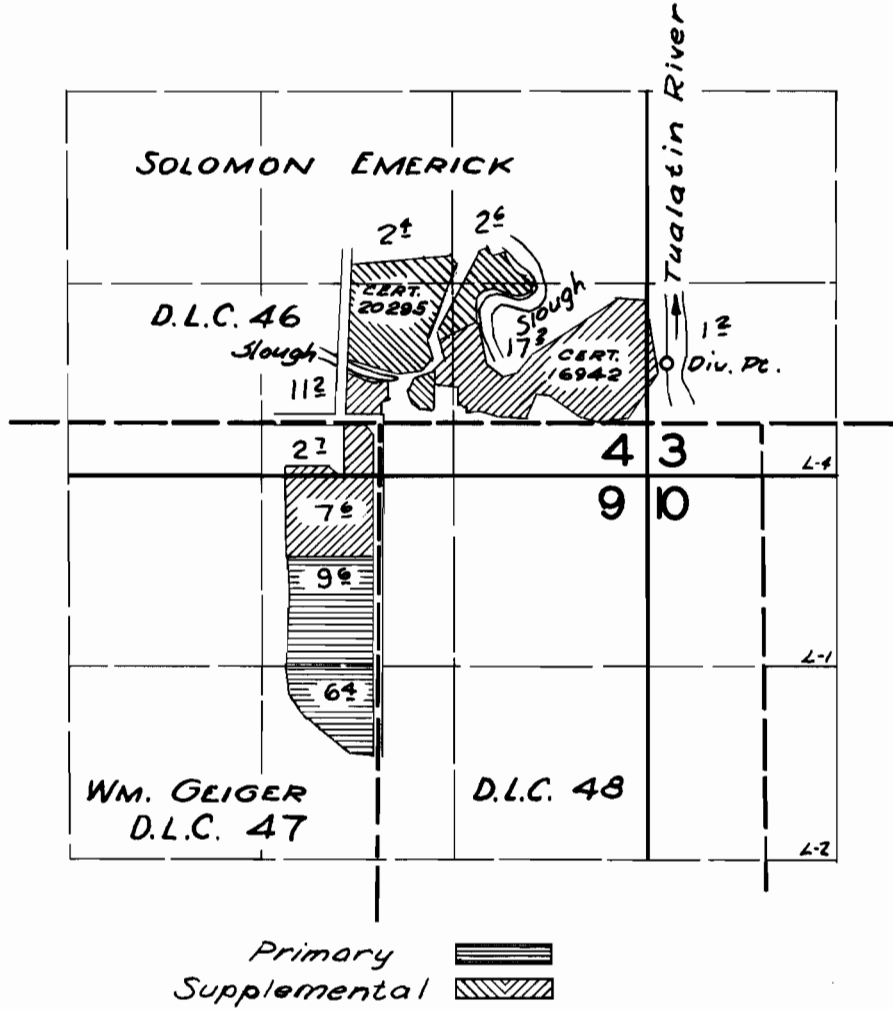

## FINAL PROOF SURVEY UNDER

Application No. 30714. Permit No. 24289  
IN NAME OF

**KLEM STUTZER**

Surveyed 18 April 1958, by C.O. Bartels