


T.10S. R.2 W.W.M.

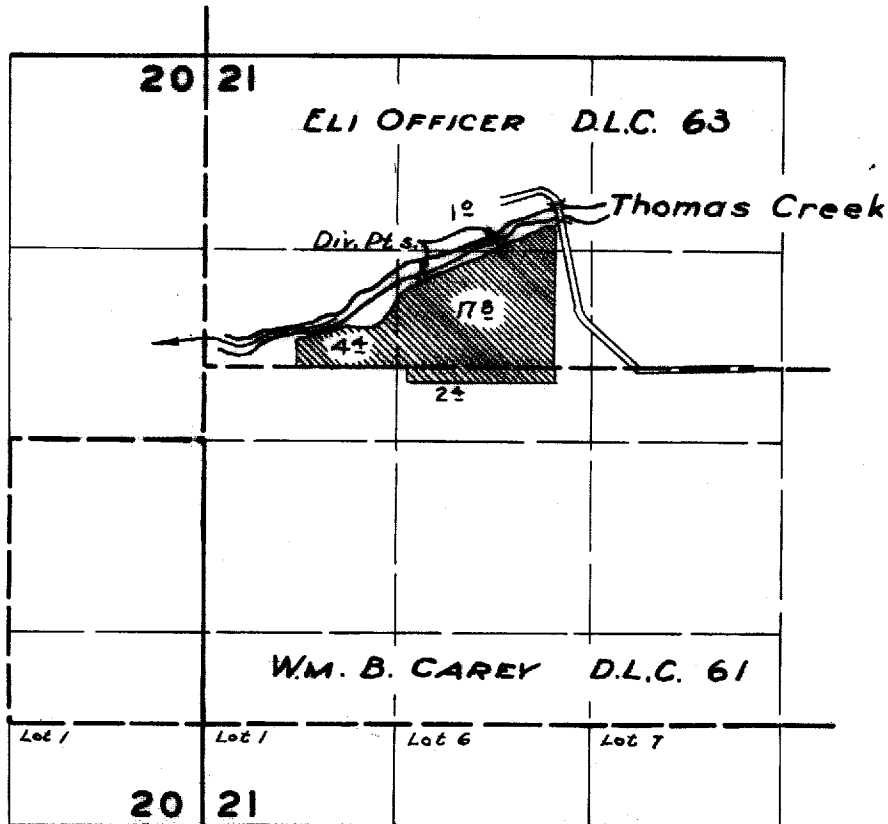

FINAL PROOF SURVEY
UNDER

Application No. 27587. Permit No. 24491.
IN NAME OF

ANDREW J. SCHATZ

Surveyed 11 July 1958, by C.O. Bartels.