


T.17S. R.47E.W.M.

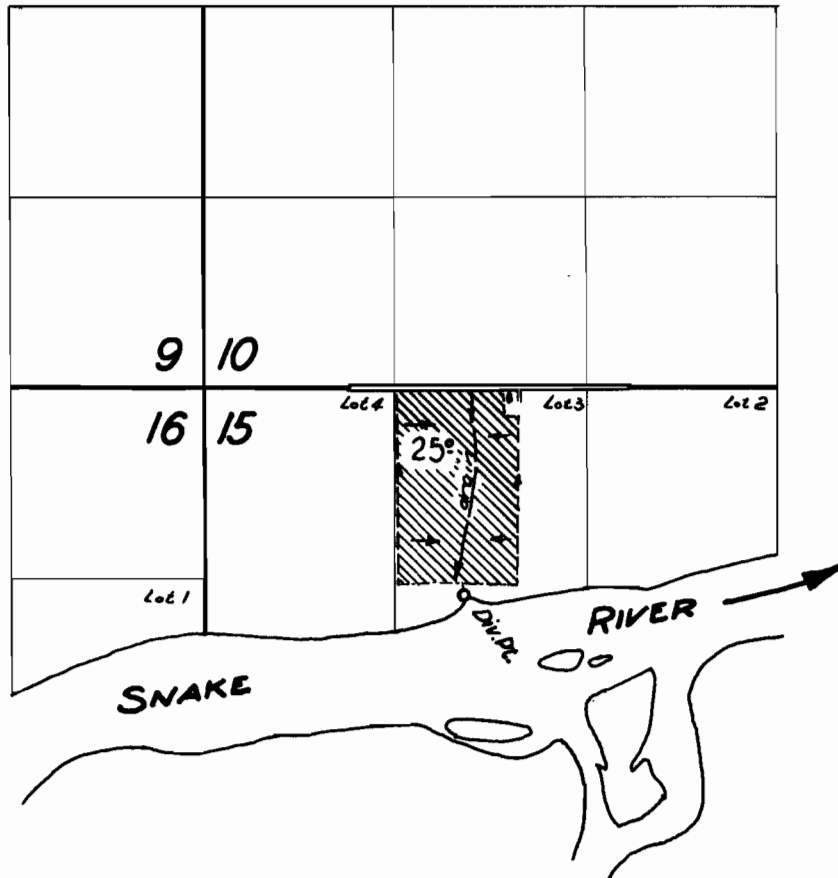

**FINAL PROOF SURVEY**  
UNDER

Application No. 31218 ... Permit No. 24607  
IN NAME OF

**C. A. TEEL**

Surveyed 29 Oct. 1958, by C.O. Bartels