


T.17 S. R. 47 E. W.M.

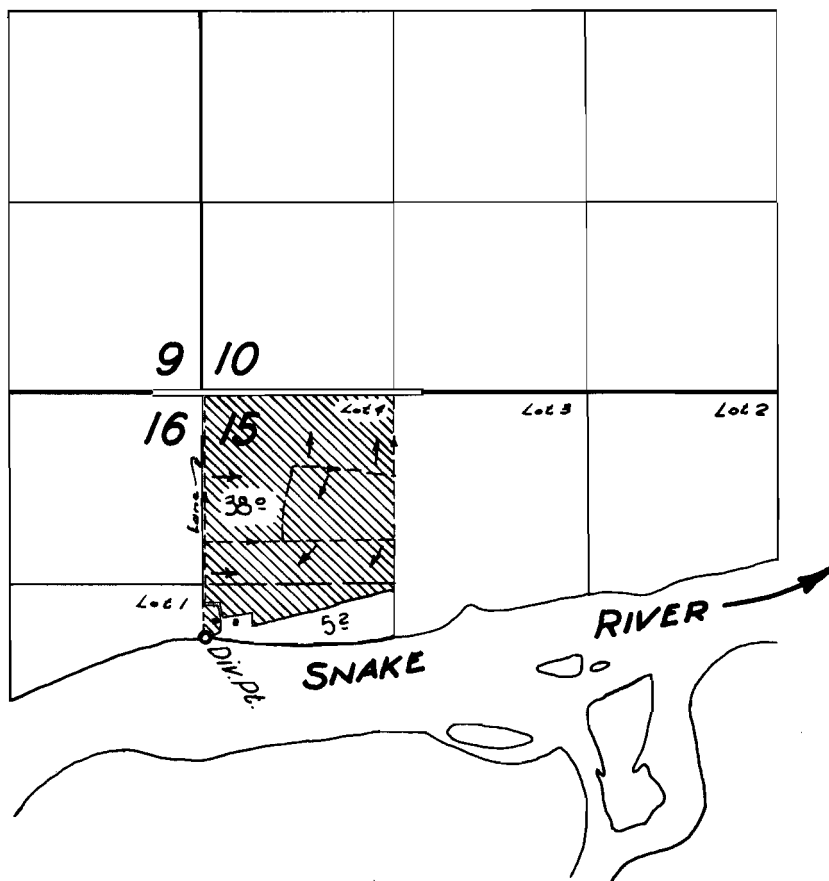

FINAL PROOF SURVEY
UNDER

Application No. 31256.. Permit No. 24626
IN NAME OF

ROY M. SMITH

Surveyed 29 Oct. 1958, by C.O. Bartels