


T. 4S. R. 2E. W.M.

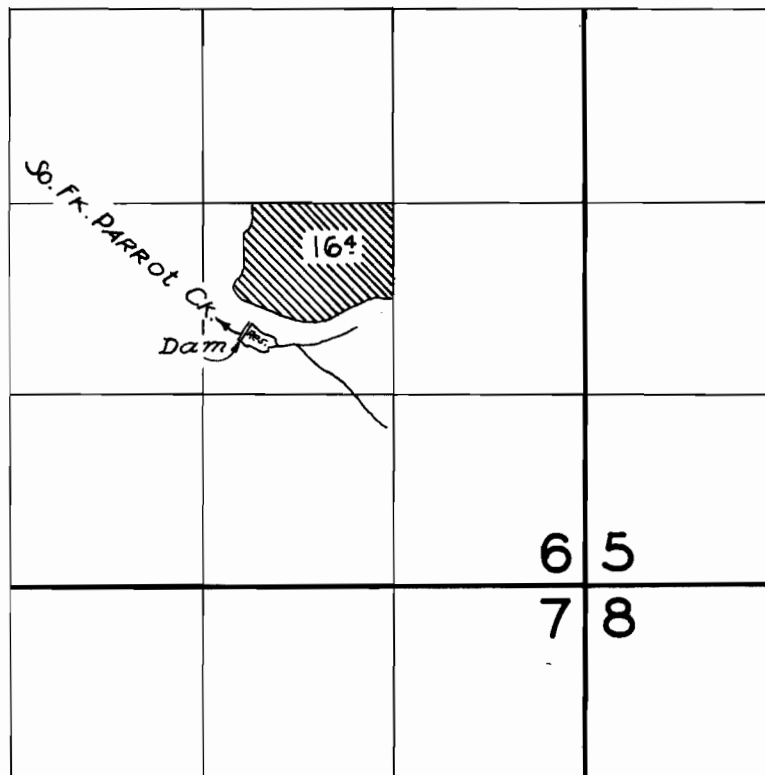

**FINAL PROOF SURVEY**  
UNDER

Application No. 31384... Permit No. 24745  
IN NAME OF

**OTIS HUNT**

Surveyed 14 August 1958, by C.O. Bartels.