


T. 14 S. R. 1 E. W. M.

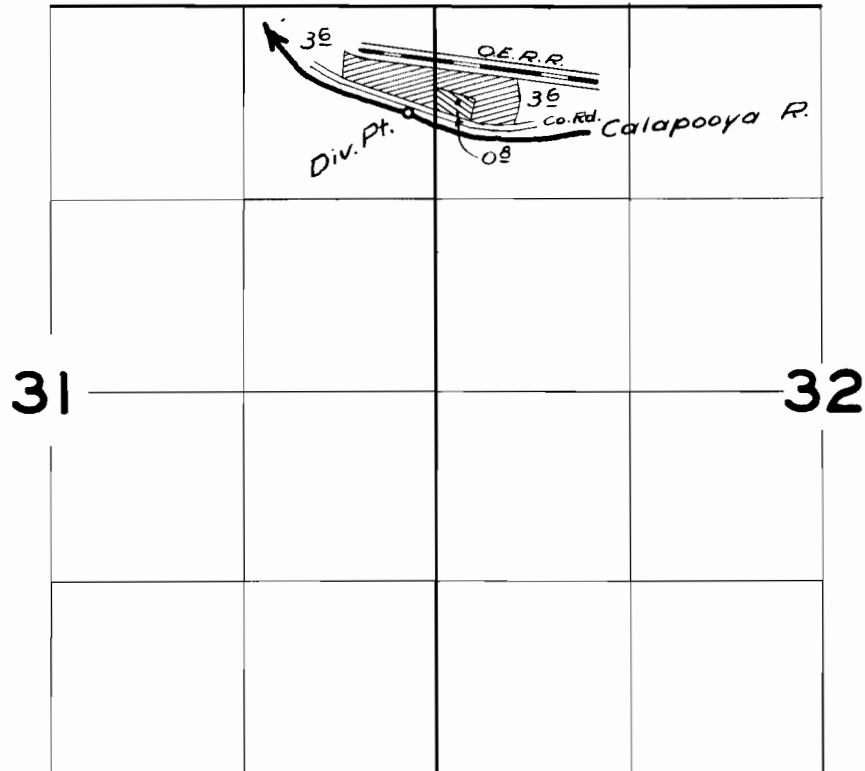

Primary 
Supplemental 

FINAL PROOF SURVEY UNDER

Application No. 31655 Permit No. 24942
IN NAME OF

GAIL J. CASWELL

Surveyed 9 Sept. 1958, by C.O. Bartels