


T.6S. R.5 W.W.M.

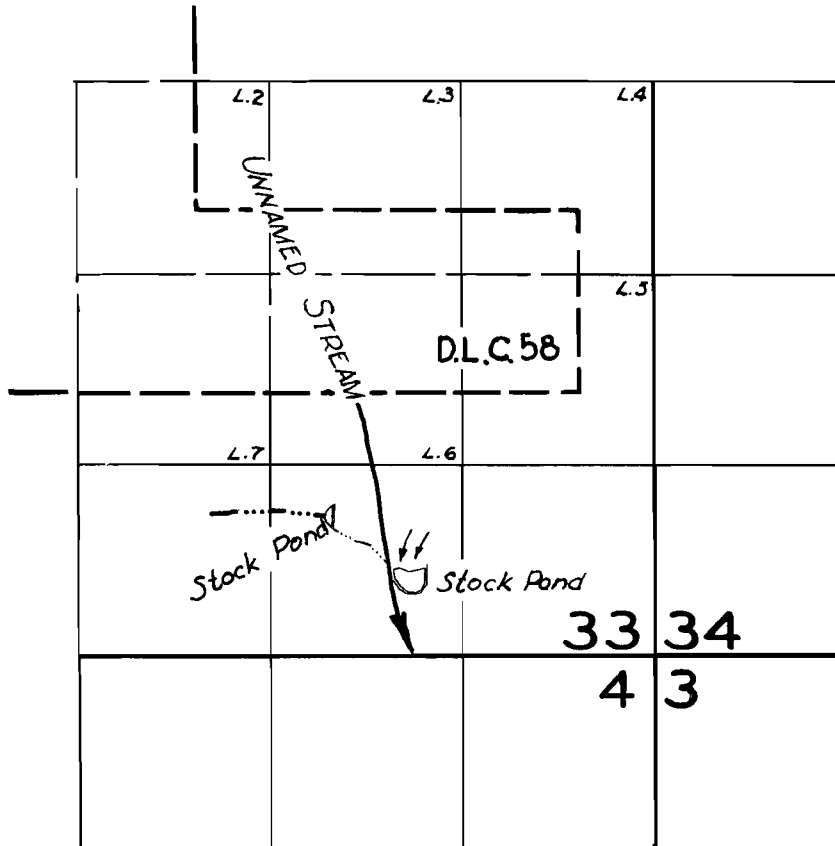

**FINAL PROOF SURVEY**  
UNDER

R-31779                      R-2058  
Application No. 31780      Permit No. 25049  
IN NAME OF

**ELVIN KENNETH MOSEBY**

Surveyed April 2, 1958, by R.H. Whitby