


T.6S. R.5 W.W.M.

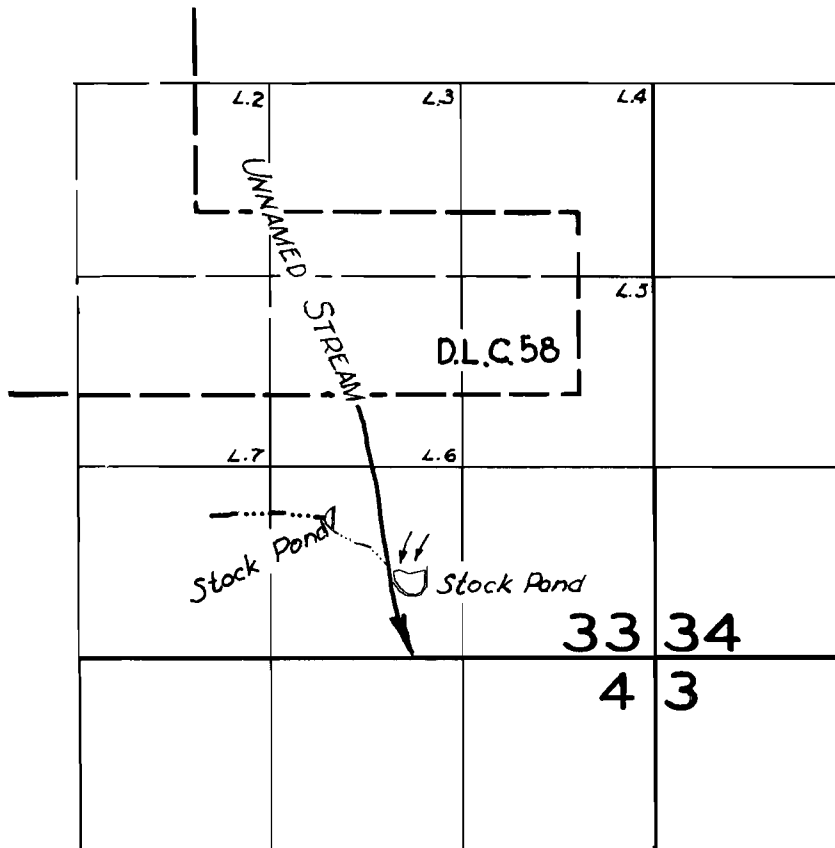

FINAL PROOF SURVEY
UNDER

R-31779 R-2058
Application No. 31780 Permit No. 25049
IN NAME OF

ELVIN KENNETH MOSEBY

Surveyed April 2, 1958, by R.H. Whitby