


T. 33 S., R. 2 E., W.M.

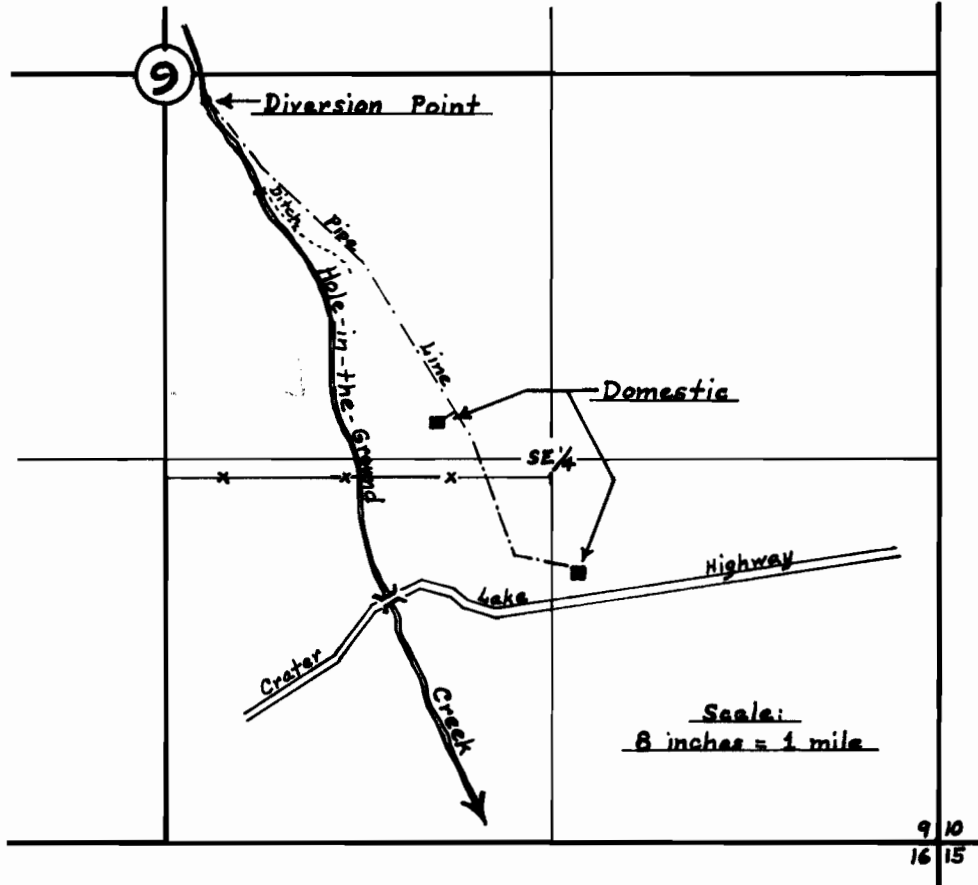

FINAL PROOF SURVEY
UNDER

Application No. ~~32756~~ Permit No. ~~25854~~
IN NAME OF

Christine E. Dobbyn and T. C. Cunningham

Surveyed Dec. 9, 1959, by *D. C. Hendrix, W.M.*