


T.26S. R.4W.W.M.

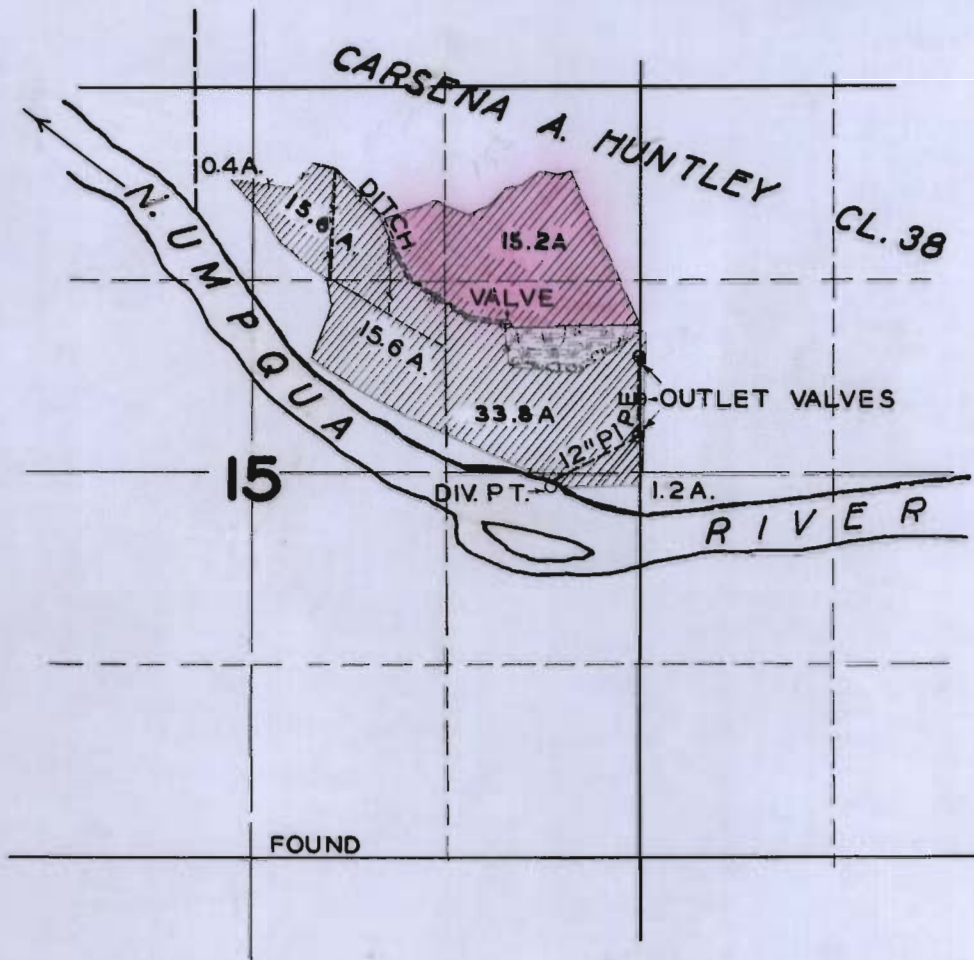

FINAL PROOF SURVEY
UNDER

Application No. 16550 Permit No. 12340
IN NAME OF

R. B. OLIVER

Surveyed JULY 13 1949, by H. L. COFFMAN

*Note: Area shaded in red
crayon was surveyed
May 5, 1953 subsequent
to issuance of
Certificate 19656*