


T.25 S.R.34 E.W.M.

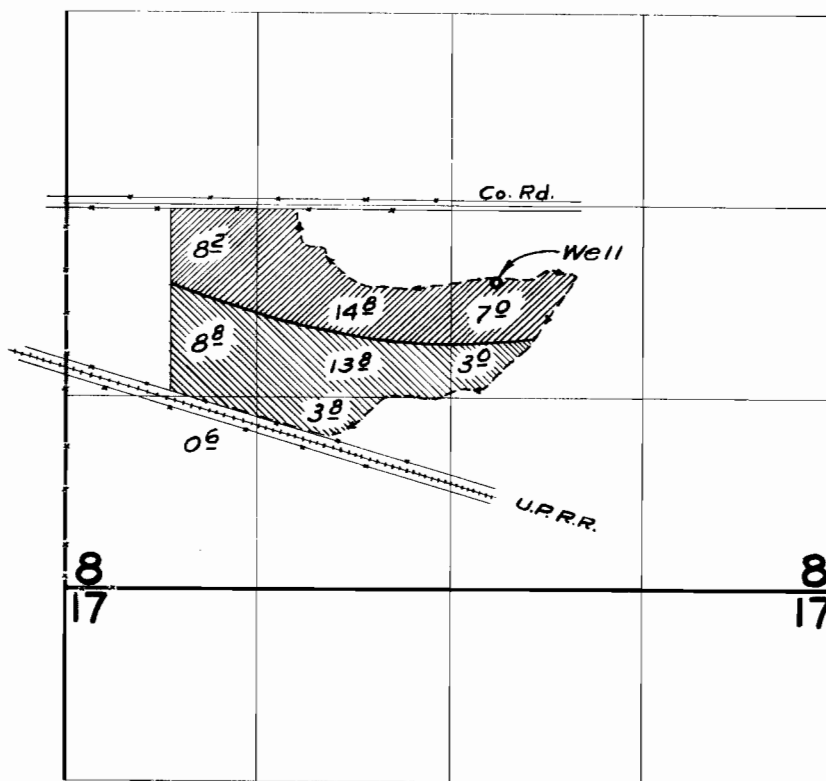

FINAL PROOF SURVEY UNDER

Application No. *G-511* Permit No. *G-548*
LI-506 *LI-470*
IN NAME OF

HENRY C. KELLEY

Surveyed *5 Aug.* 1958, by *M. B. Bish*