


T.5 S.R.2 W.W.M.

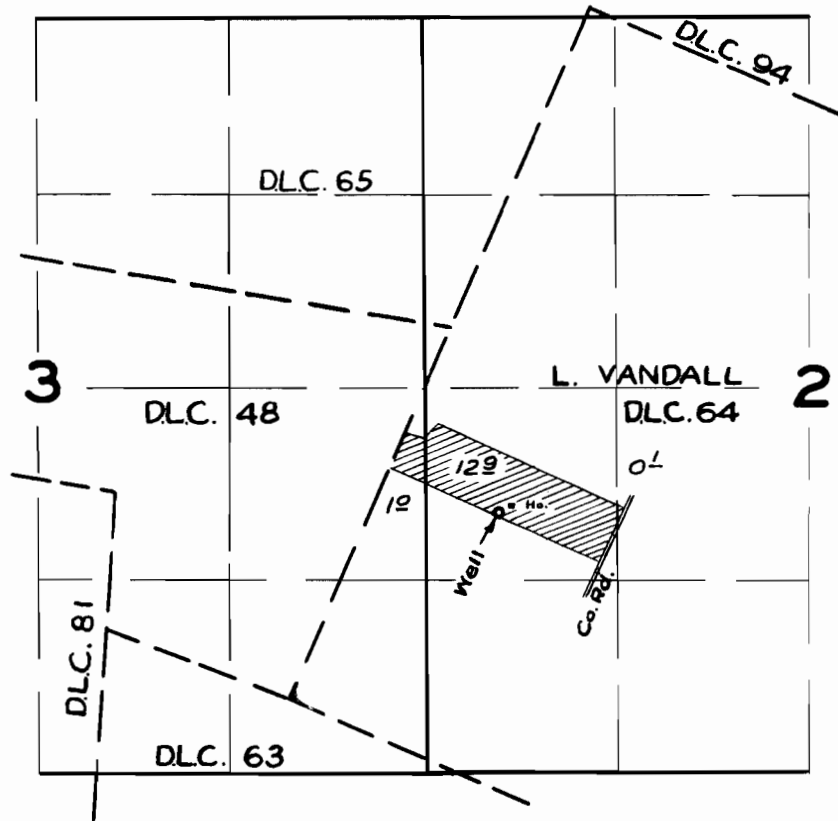

FINAL PROOF SURVEY UNDER

Application No. G-211 Permit No. G-130
IN NAME OF

HENRY DINGES

Surveyed APR. 24 1958, by C.O. Bartels