


T.17S.R.3W.W.M.

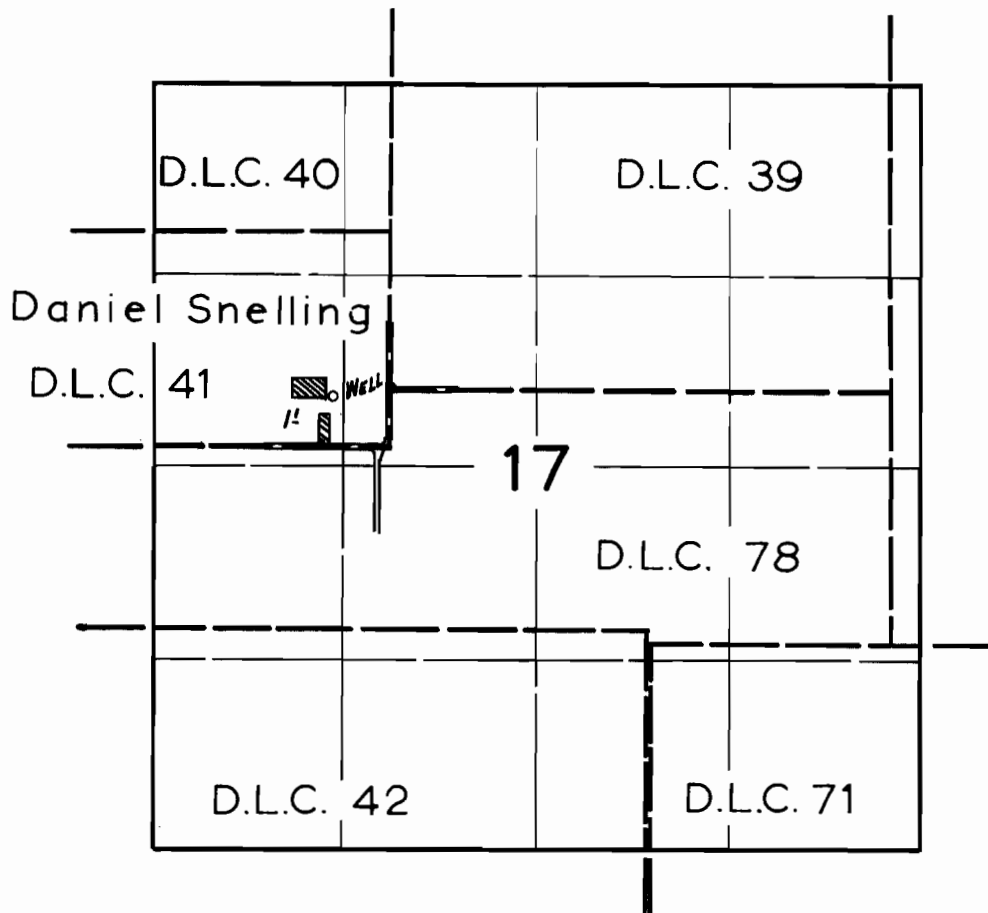

FINAL PROOF SURVEY
UNDER

Application No. G-277. Permit No. G-189.
IN NAME OF

John H. McDonald

Surveyed April 1, 1959, by *R. Jackson*