T.6S. R.1 W.W.M.

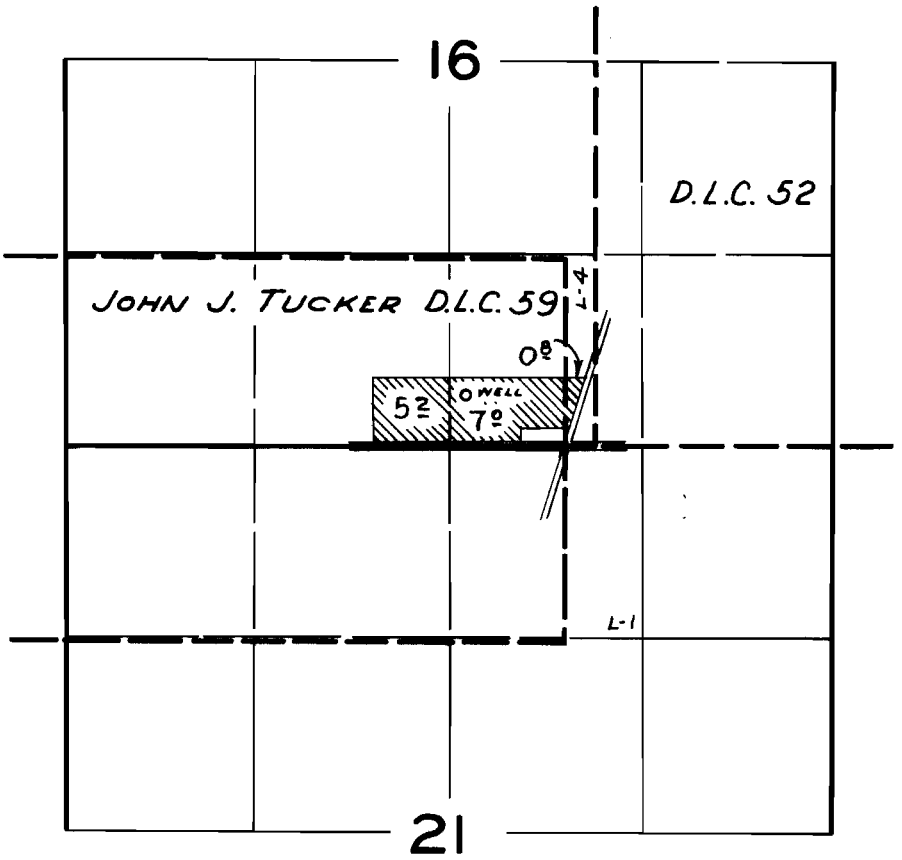

FINAL PROOF SURVEY
UNDER

Application No. G-427 Permit No. G-291
IN NAME OF

LESTER HARPOLE

Surveyed 16 April 1958, by C.O. Bartels

1958-X