


T. 19S. R. 3W.W.M.

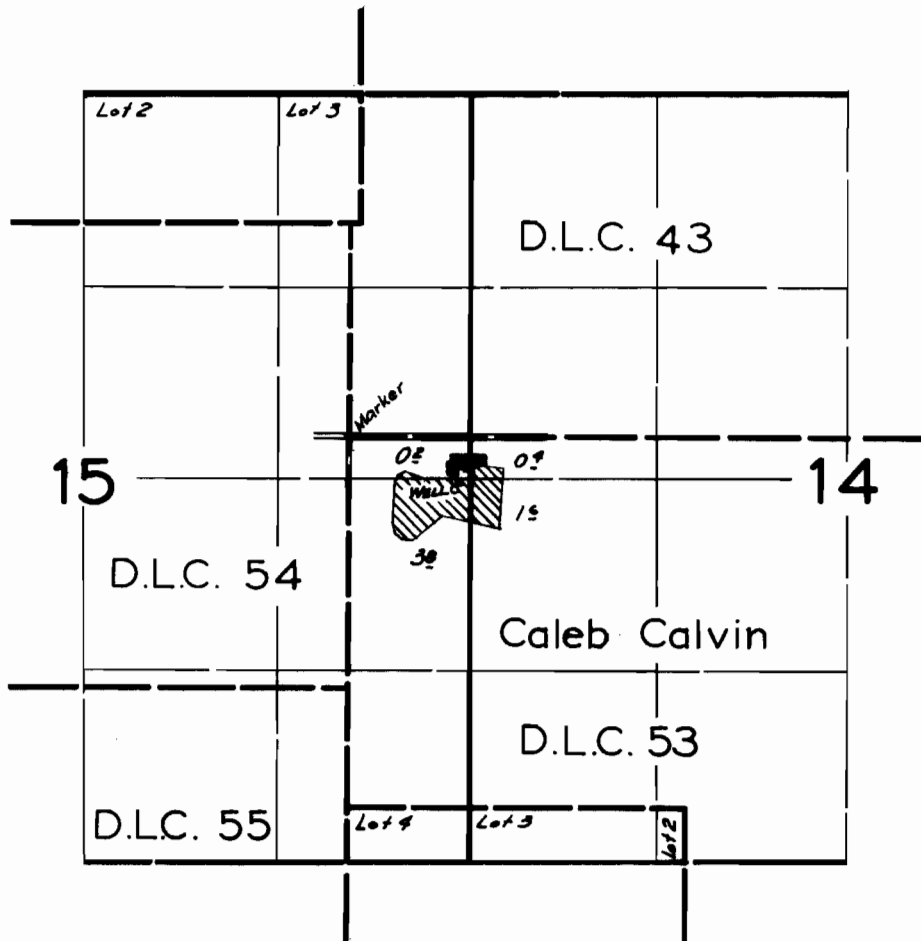

FINAL PROOF SURVEY
UNDER

Application No. *G-713* Permit No. *G-629*
IN NAME OF

CRESWELL UNION HIGH SCHOOL DIST. # U-12

Surveyed *26 Mar.* 1959, by *R.H. Jackson*