


T.6N. R.35E.W.M.

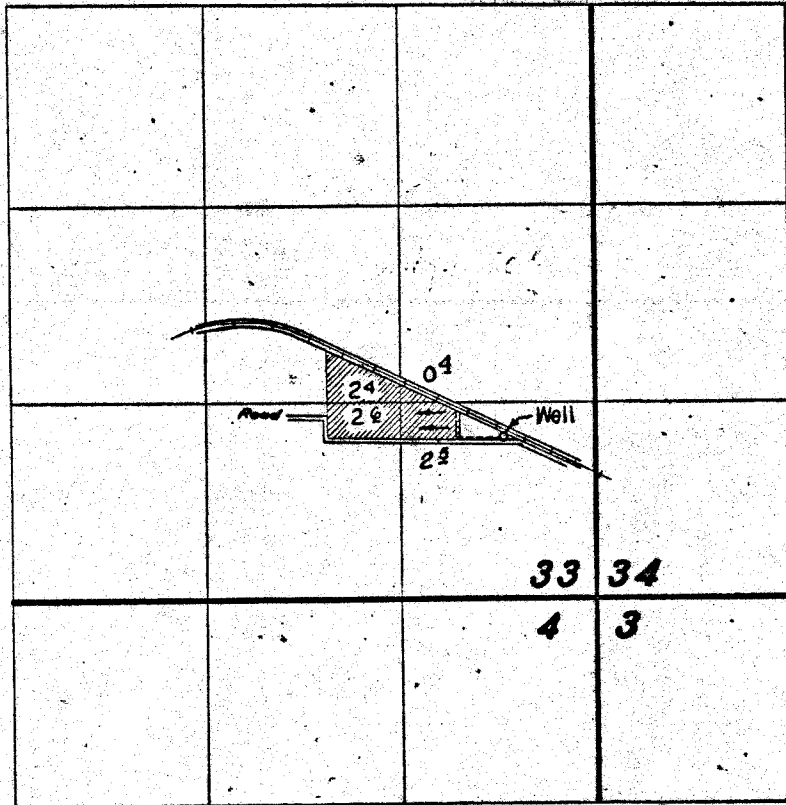

FINAL PROOF SURVEY UNDER

Application No. G-800... Permit No. G-757.
IN NAME OF

ARCHIE & WILENA M. HEALD

Surveyed 14. Nov. 1958, by C.O. Bartels.