


T.6 N. R. 35 E. W.M.

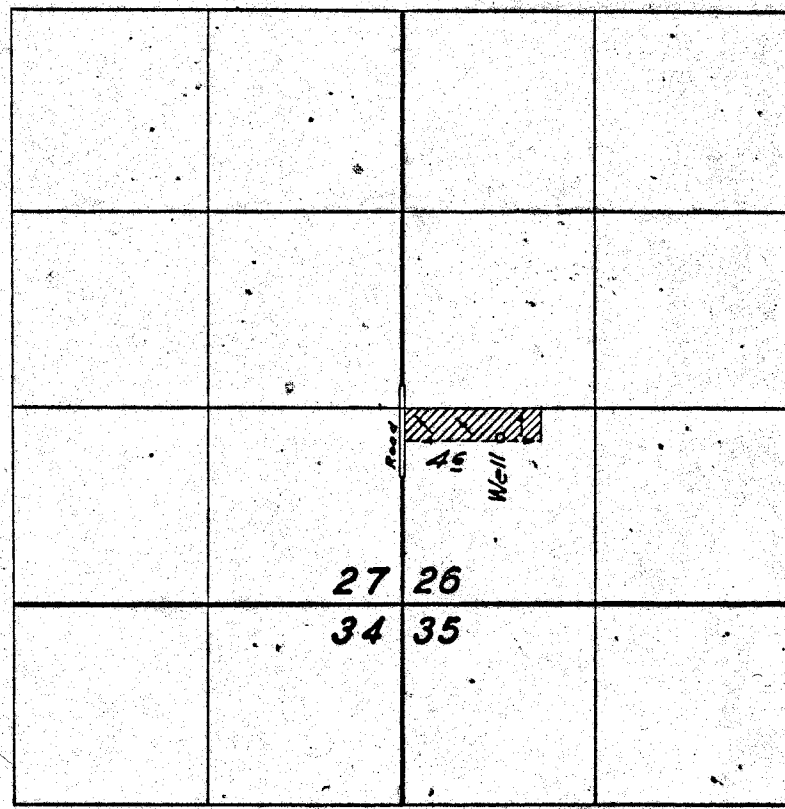

FINAL PROOF SURVEY UNDER

Application No. G-942. Permit No. G-836.
IN NAME OF

FRANK DERRICK

Surveyed 13. Nov. 1958., by C.O. Bartels...