


T.6N. R.35E.W.M.

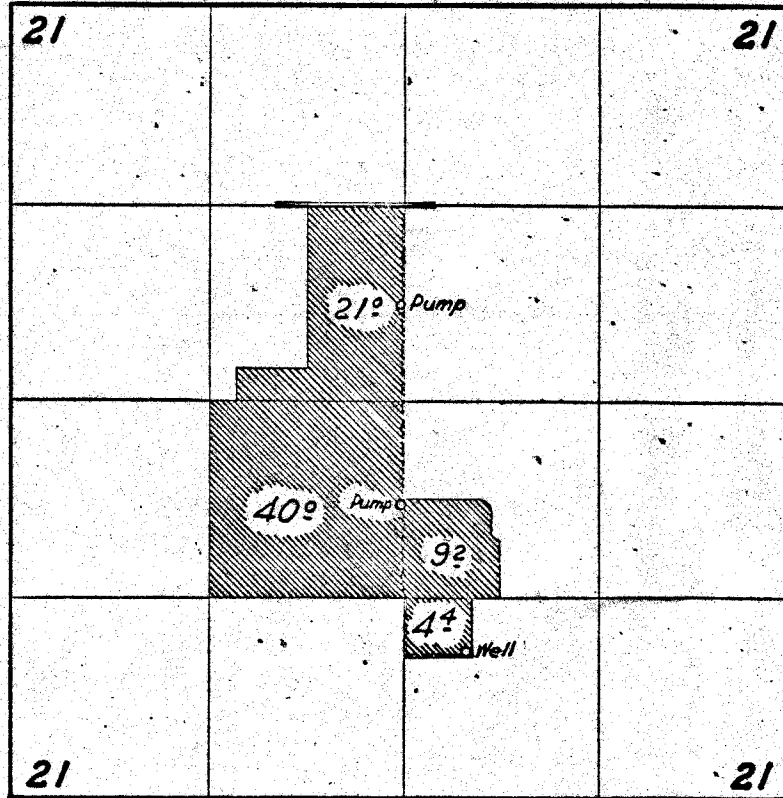

FINAL PROOF SURVEY UNDER

Application No. G-868... Permit No. G-918...
IN NAME OF

WALTHEN L. KINCHELOE

Surveyed 13 Nov. 1958., by C.O. Bartels