


T. 2 S. R. 4 E. W. M.

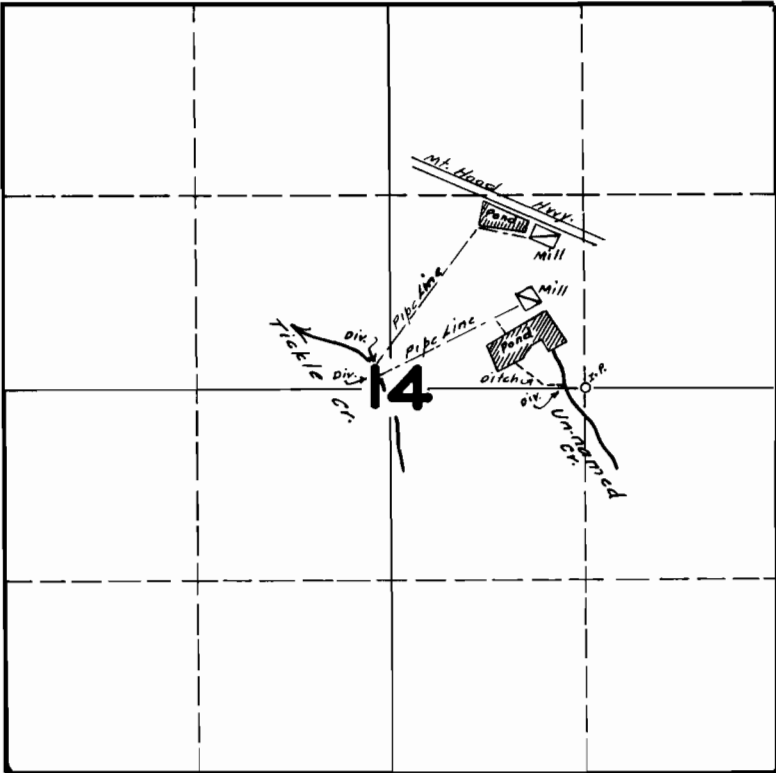

FINAL PROOF SURVEY

UNDER

Application No. 19188 Permit No. 4785

IN NAME OF

SANDY MARKET INC

Surveyed, JUNE 18 1946, by *[signature]*

1946-D