



T. 19S. R. 35E. W.M.

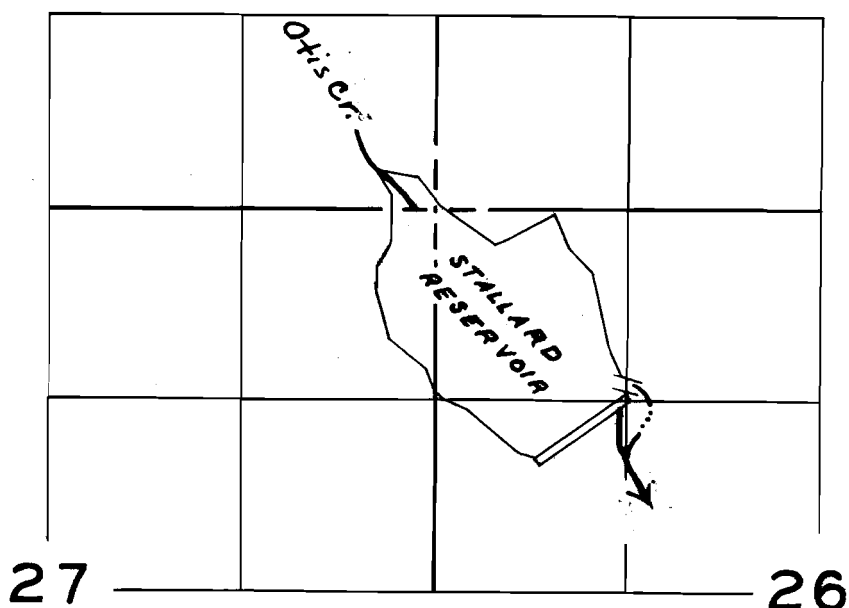

T. 19 S. R. 35 & 36 E. W.M.

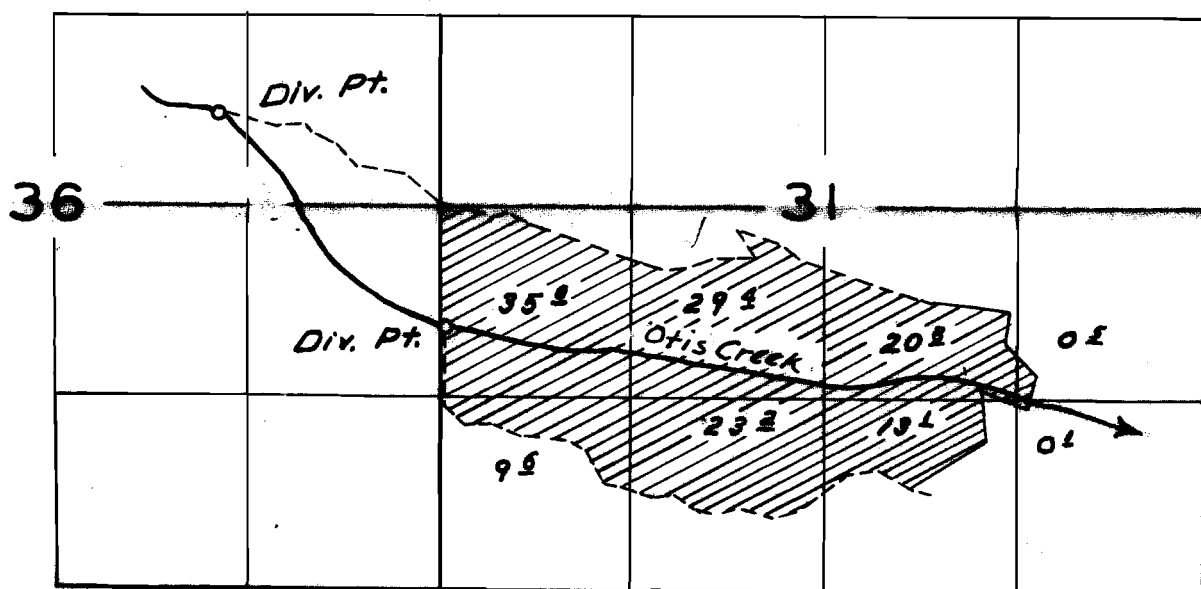

FINAL PROOF SURVEY
UNDER

APPL. NO.	R 22183 22184 R23537 23538	PERMIT NO.	R 868 17533 R964 18586
-----------	-------------------------------------	------------	---------------------------------

IN NAME OF
CHESTER H. STALLARD
SURVEYED AUG. 18 1958 BY WN. PERRY