


T.10 11S. R.9 W.W.M:

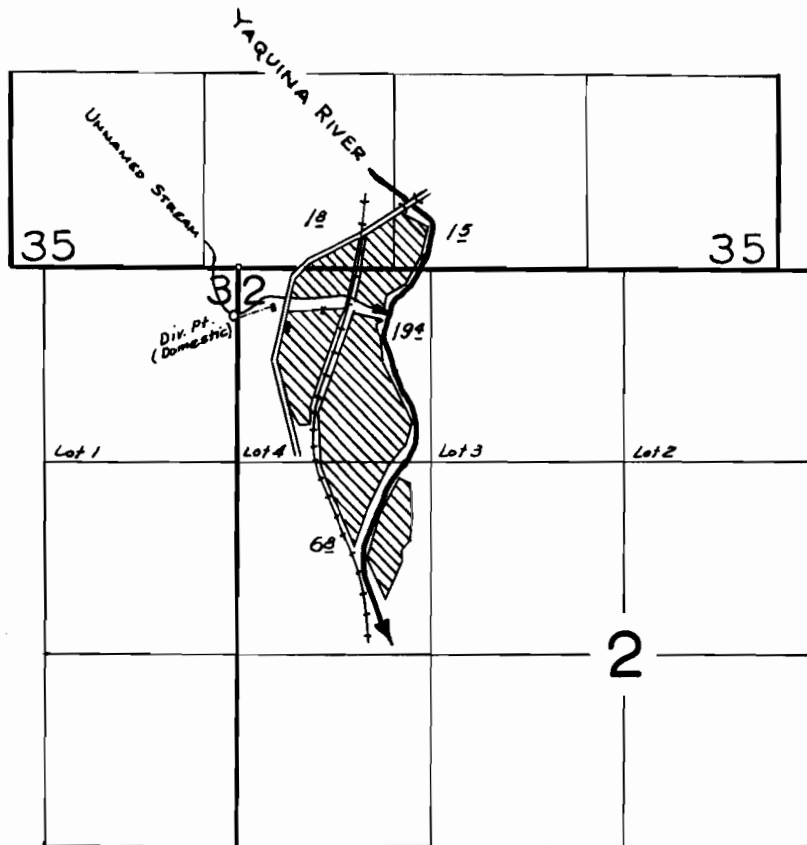

FINAL PROOF SURVEY
UNDER

Application No. ²²³⁶¹30664 Permit No. ¹⁷⁶⁹⁸24499.....
IN NAME OF

ROBERT H. & HARRIETTE L. WESTFALL

Surveyed 1 May 1959, by *R. Jackson*