


T. 36 S. R. 7 W. W. M.

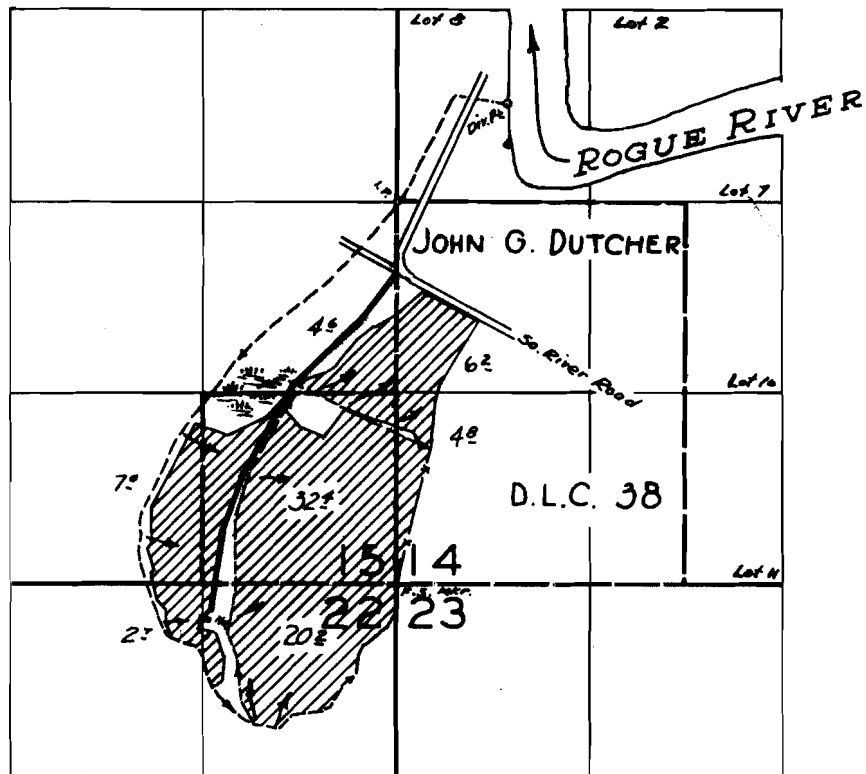

FINAL PROOF SURVEY
UNDER

Application No. 23876. Permit No. 18796.
IN NAME OF

PHILIP J. HUSSEY

Surveyed July 23, 1959, by *R. H. Jackson*