


T.36S. R.1 W.W.M.

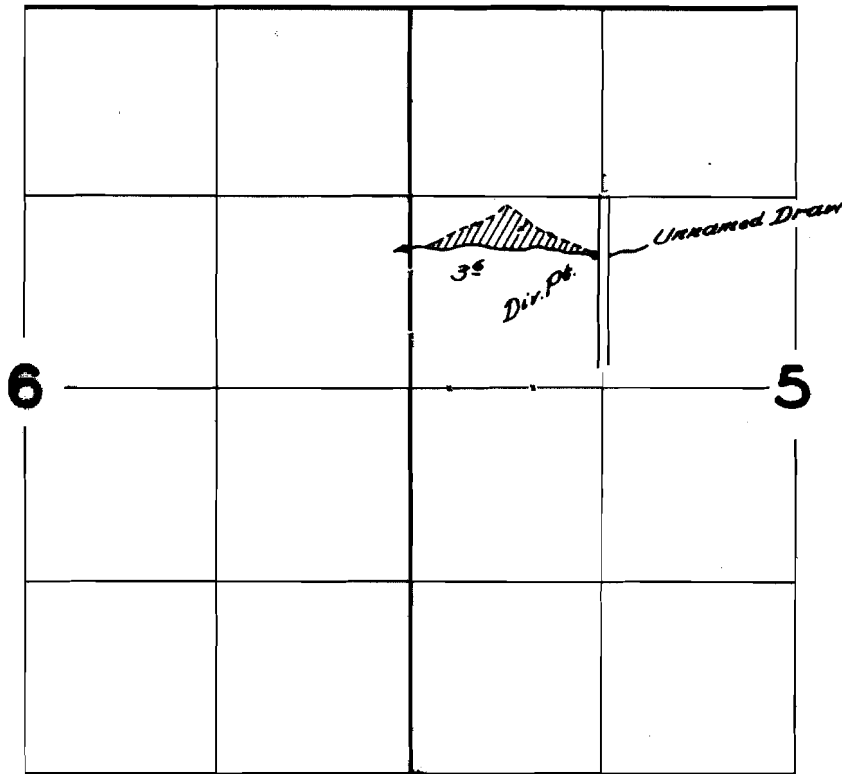

**FINAL PROOF SURVEY**  
UNDER

Application No. *23973* Permit No. *18918*.....  
IN NAME OF

.....*C. E. Smith*.....

Surveyed *May 11*, 1959, by *C. D. Bault*.....