


T. 33 S. R. 8 W. W. M.

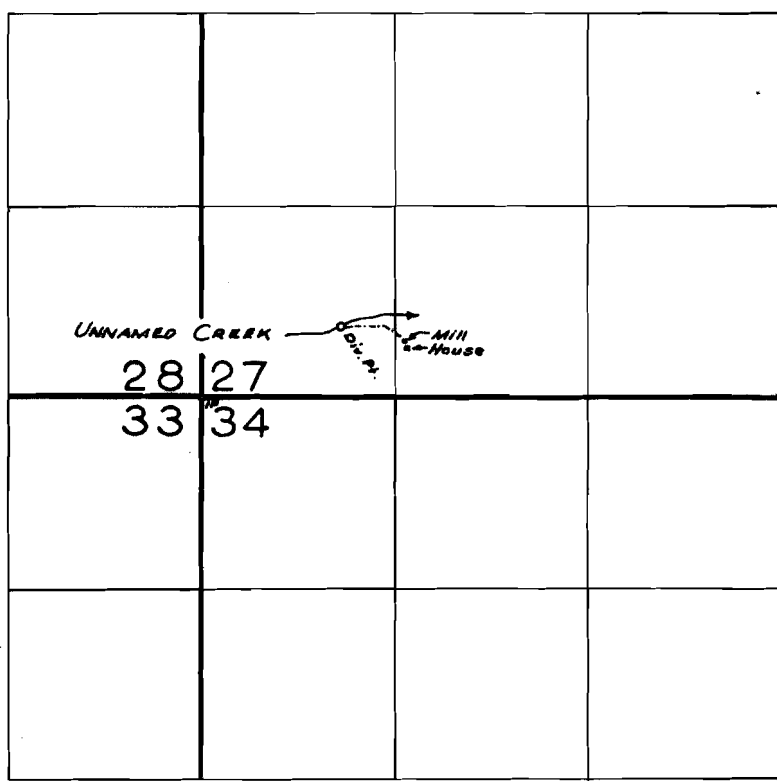

FINAL PROOF SURVEY
UNDER

Application No. 24475. Permit No. 19290.
IN NAME OF

..... QUENTIN STONE

Surveyed July 24, 1959, by R. Jackson