


T4I SR13WWM

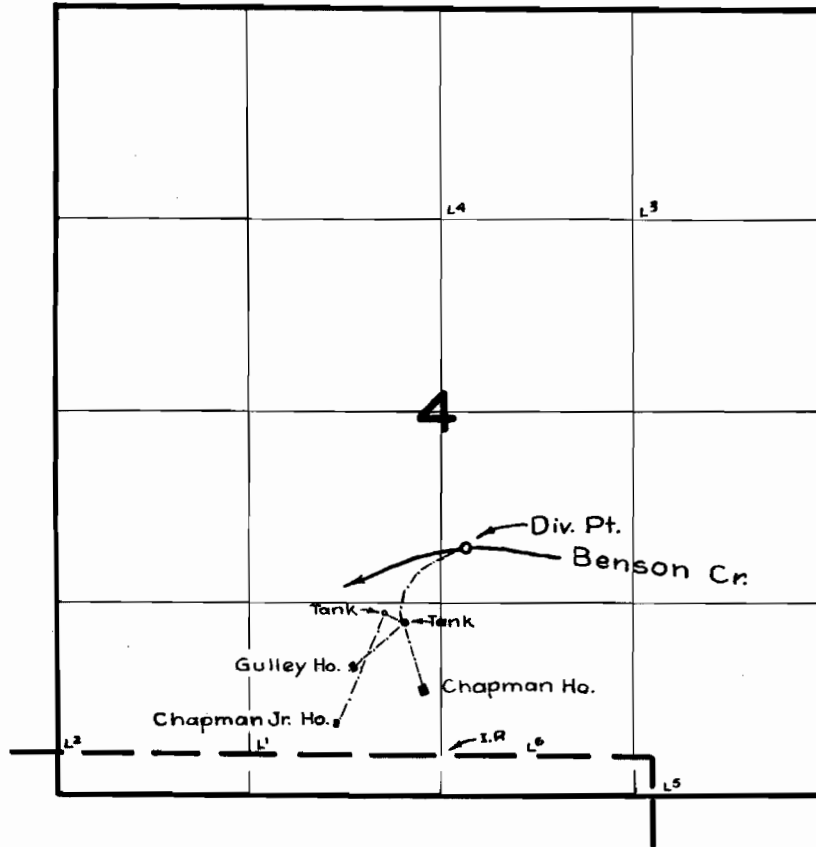

FINAL PROOF SURVEY UNDER

Application No. 24562 Permit No. 19364
IN NAME OF

Surveyed Mar. 19, 1958, by M. Bish