


T.13S. R.1E.W.M.

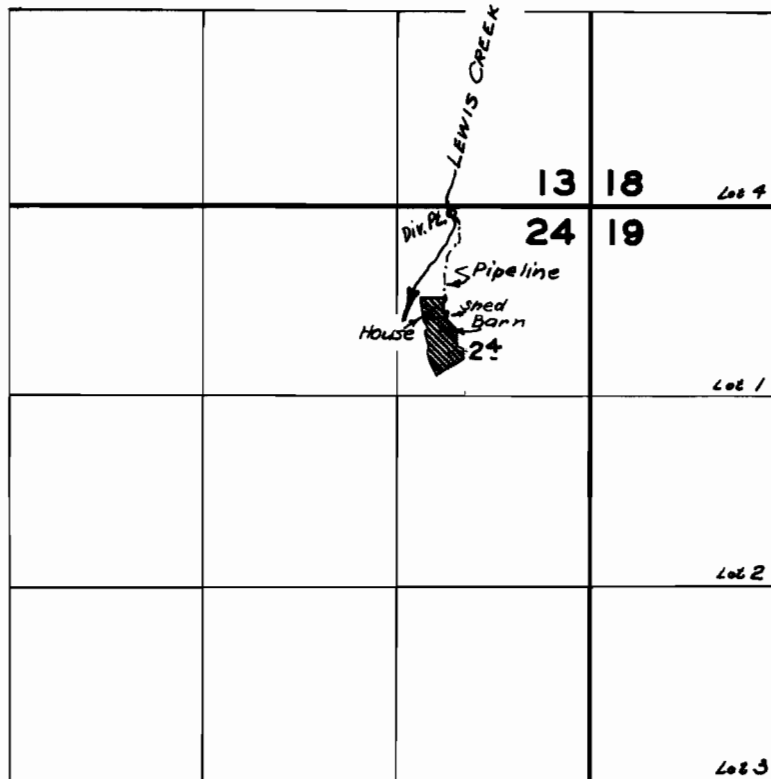

FINAL PROOF SURVEY
UNDER

Application No. 24725. Permit No. 19499.
IN NAME OF

A. B. & LOTTIE M. SIMONS

Surveyed 11. Sept. 1958, by C.O. Bartels.